


Pre Re-Plugging

Well	Green 1-13
Operator	DIVERSIFIED OPERATING CORPORATION - 24461
API	05-123-20111
Spud Date	10/18/2000
Original Abandon date	10/23/2001
Location	Lat/Long: 40.599275/-104.04741
Location	SWSW Sec 1- 7N-60W

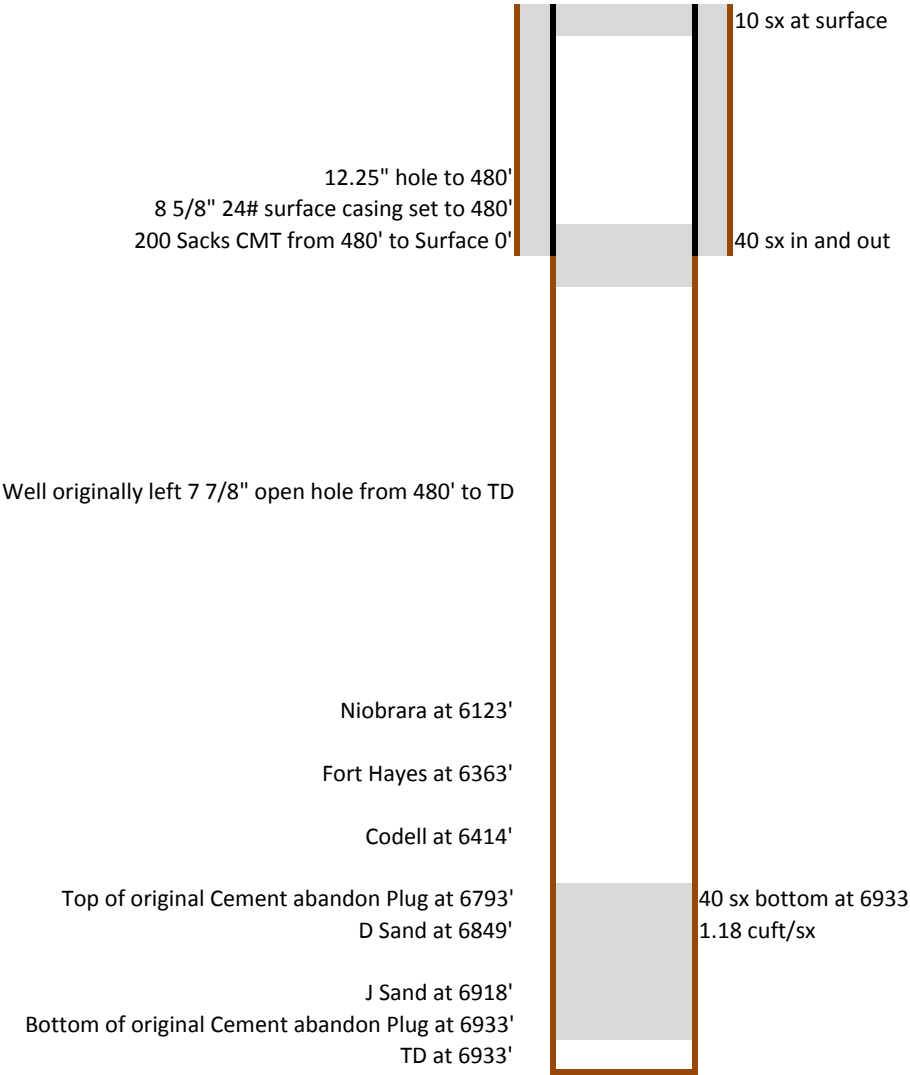

Post Re-Plugging

Well	Green 1-13
Operator	DIVERSIFIED OPERATING CORPORATION - 24461
API	05-123-20111
Spud Date	10/18/2000
Original Abandon date	10/23/2001
Location	Lat/Long: 40.599275/-104.04741
Location	SWSW Sec 1- 7N-60W

