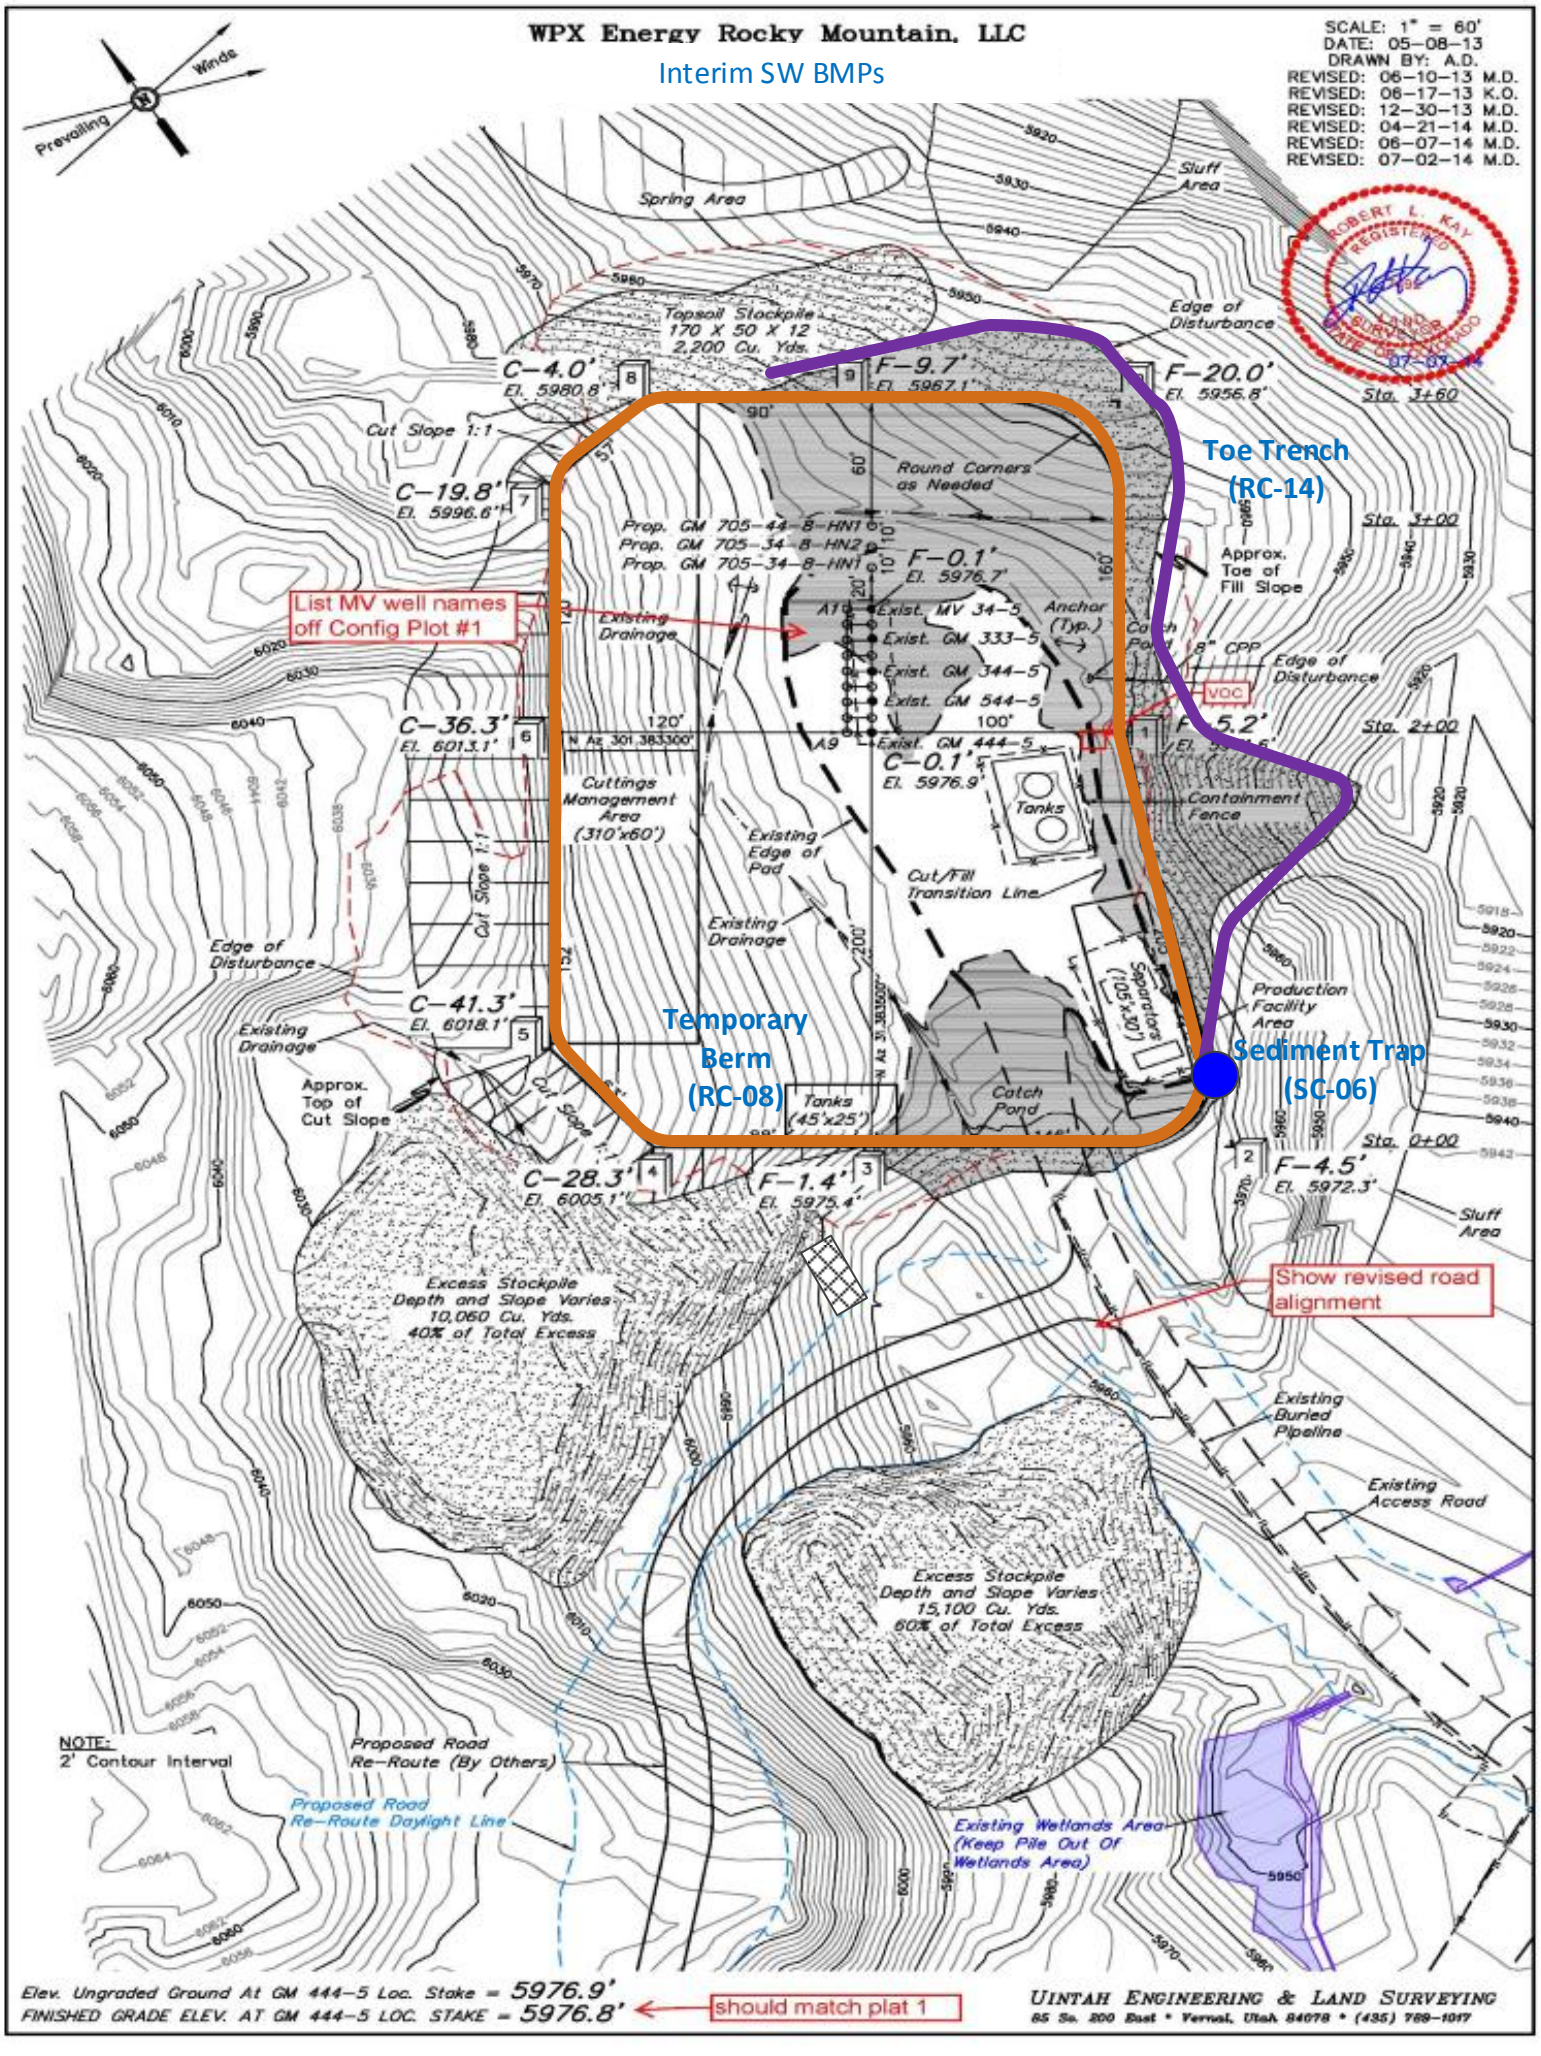
WPX Energy Rocky Mountain, LLC
Interim SW BMPs
SCALE: 1" = 60'
DATE: 05-08-13
DRAWN BY: A.D.
REVISED: 06-10-13 M.D.
REVISED: 06-17-13 K.O.
REVISED: 12-30-13 M.D.
REVISED: 04-21-14 M.D.
REVISED: 06-07-14 M.D.
REVISED: 07-02-14 M.D.
Prevailing Winds
Spring Area
Sluff Area
Topsoil Stockpile 170 X 50 X 12 2,200 Cu. Yds.
Edge of Disturbance
C-4.0' El. 5980.8'
F-9.7' El. 5967.1'
F-20.0' El. 5956.8'
Sta. 3+60
Cut Slope 1:1
C-19.8' El. 5996.6'
Round Corners as Needed
Prop. GM 705-44-8-HN1
Prop. GM 705-34-8-HN2
Prop. GM 705-34-8-HN1
F-0.1' El. 5976.7'
Toe Trench (RC-14)
Sta. 3+00
Approx. Toe of Fill Slope
List MV well names off Config Plot #1
Existing Drainage
Exist. MV 34-5
Anchor (Typ.)
Exist. GM 333-5
Exist. GM 344-5
Exist. GM 544-5
Exist. GM 444-5
8" CPP
Edge of Disturbance
VOC
C-36.3' El. 6013.1'
C-0.1' El. 5976.9'
Sta. 2+00
Cuttings Management Area (310'x60')
Tanks
Containment Fence
Existing Edge of Pad
Cut/Fill Transition Line
Existing Drainage
Edge of Disturbance
C-41.3' El. 6018.1'
Separators (105'x30')
Production Facility Area
Temporary Berm (RC-08)
Sediment Trap (SC-06)
Existing Drainage
Approx. Top of Cut Slope
Tanks (45'x25')
Catch Pond
C-28.3' El. 6005.1'
F-1.4' El. 5975.4'
Sta. 0+00
F-4.5' El. 5972.3'
Sluff Area
Excess Stockpile Depth and Slope Varies 10,060 Cu. Yds. 40% of Total Excess
Show revised road alignment
Existing Buried Pipeline
Existing Access Road
Excess Stockpile Depth and Slope Varies 15,100 Cu. Yds. 60% of Total Excess
NOTE: 2' Contour Interval
Proposed Road Re-Route (By Others)
Proposed Road Re-Route Daylight Line
Existing Wetlands Area (Keep Pile Out Of Wetlands Area)
Elev. Ungraded Ground At GM 444-5 Loc. Stake = 5976.9'
FINISHED GRADE ELEV. AT GM 444-5 LOC. STAKE = 5976.8'
should match plat 1
UINTAH ENGINEERING & LAND SURVEYING
85 So. 200 East • Vernal, Utah 84078 • (435) 789-1017