


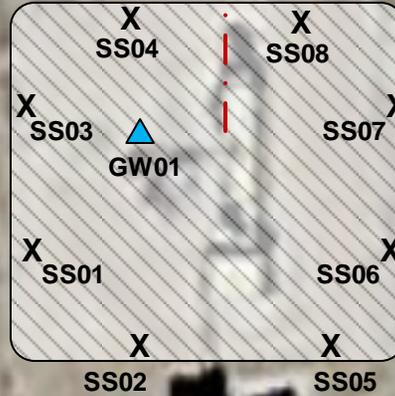


Surface
Drainage
Unknown



Agriculture

Access Road

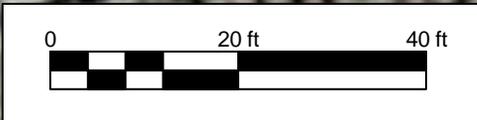

DRAWN BY: CAW

DATE: 10/27/2014

Facility Diagram
 PDC Energy, Inc. – DJ Basin
 Miller GJ 33-24
 NWSE S24 T6N R65W
 Weld County, CO



6899 Pecos Street, Unit C
 Denver, CO 80221

LEGEND	
	Approximate Area of Excavation
	PDC Flow Line
	DCP Gas Line
	Soil Sample Location
	Groundwater Sample Location

FIGURE 2
 EXCAVATION
 SITE MAP