

**KERR-MCGEE OIL AND GAS ONSHORE LP**

**UPRR 50 PAN AM D-7**

**SW NW 3 1N 66W 1,845' FNL 660' FWL**


**WELD,COLORADO**

**11/10/2014**

**AREA:**                      **ROUTE:**                      **Spud: 10/29/1985**                      **WINS No.: H8818**                      **AFE/WO#: 2100125**                      **API#: 0512312677**

**GL: 5018**    **KB: 5028**    **MTD: 8115**    **TVD: 8115**    **LOG MD: 4670**    **PBMD: 7990**    **PBTVD: 7990**

**Directions:**    **CR 14 & CR 31, E 1/10, S 3/10 INTO. FARM YARD**

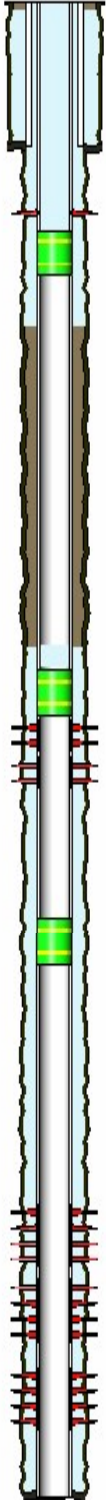

<u>HOLE SECTIONS</u>	<u>Size</u>	<u>Top</u>	<u>Btm</u>	<u>TD Date</u>				
SURFACE	12.25	10	778	10/29/1985				
PRODUCTION	7.88	778	8115	11/06/1985				
<u>TUBULARS</u>	<u>Tool Type</u>	<u>Joints</u>	<u>Size</u>	<u>Weight</u>	<u>Grade</u>	<u>Thread</u>	<u>Top D</u>	<u>Bottom D</u>
SURFACE CASING	Casing	18	8.63	24	K-55	STC	10	778
PRODUCTION CASING	Casing		5.50	17.00			10	8115
CIBP	CIBP With CMT Cap	1	5.50				6000	6002
CIBP	CIBP With CMT Cap	1	5.50				4700	4702
CAST IRON CEMENT RETAINER	Cement Retainer	1	5.50				1220	1223
<u>CEMENT JOBS</u>	<u>Stage</u>	<u>Sacks</u>	<u>Cement Jobs</u>			<u>Top D</u>	<u>Btm D</u>	<u>cbl</u>
SURFACE CASING	PRIM CMT 1ST STAGE	355	LEAD	50/50 POZ-MIX		50	500	No
	PRIM CMT 1ST STAGE	150	TAIL	A		500	778	No
PRODUCTION CASING	PRIM CMT 1ST STAGE	1080	LEAD	CEMENT		4500	8115	No
PRODUCTION CASING	REMEDIAL CEMENT	350	LEAD	CEMENT		650	1138	Yes
PRODUCTION CASING	ABANDONMENT PLUC	10		REGULAR		10	100	No
	ABANDONMENT PLUC	40		NEAT		816	1216	No
PRODUCTION CASING	SQUEEZE JOB	280	LEAD-1	FRESH WATER		1047	1680	No
PRODUCTION CASING	ABANDONMENT PLUC	30	LEAD	FRESH WATER		4480	4670	No
SURFACE CASING	SURFACE TOPOUT	157	LEAD	FRESH WATER		10	1047	No
<u>PERFORATIONS</u>								
<u>Formation</u>	<u>Zone</u>	<u>Top</u>	<u>Btm</u>	<u>Date</u>	<u>Reason</u>	<u>Comments</u>		
		1125	1126	10/01/1986	CEMENT SQUEEZE			
		1168	1680	10/02/2014	CEMENT SQUEEZE			
SUSSEX		4742	4760	06/15/1988	PRODUCTION			
SUSSEX		4826	4856	06/15/1988	PRODUCTION			
NIOBRARA		7282	7283	04/28/1986	PRODUCTION			
NIOBRARA		7282	7292	06/04/1986	PRODUCTION			
NIOBRARA		7292	7293	04/28/1986	PRODUCTION			
NIOBRARA		7360	7361	04/28/1986	PRODUCTION			
NIOBRARA		7360	7370	06/04/1986	PRODUCTION			
NIOBRARA		7370	7371	04/28/1986	PRODUCTION			
CODELL		7508	7516	06/04/1986	PRODUCTION			
CODELL		7516	7517	04/28/1986	PRODUCTION			

**Comments:**