


KERR-MCGEE OIL AND GAS ONSHORE LP
DOVE AL 22N-13HZ
NW NW 12 2N 66W 500' FNL 620' FWL
WELD,COLORADO
11/11/2014

AREA: S4 ROUTE: S43 Spud: 03/08/2013 WINS No.: F1930 AFE/WO#: 2102075 API#: 0512335903

GL: 4999 KB: 5005 MTD: 0 TVD: 0 LOG MD: PBMD: PBTVD:

Directions: WCR 22 & WCR 37, N 9/10,W 9/10 INTO

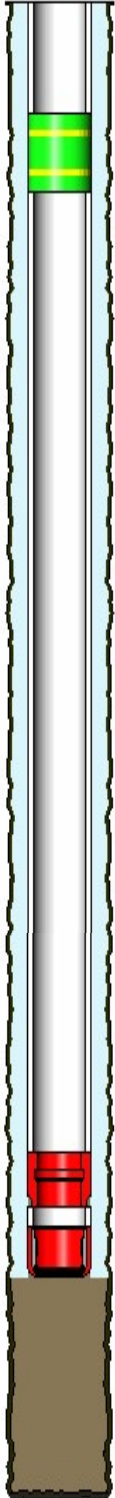

<u>HOLE SECTIONS</u>		<u>Size</u>	<u>Top</u>	<u>Btm</u>	<u>TD Date</u>			
SURFACE		13.50	6	1031	03/09/2013			
<u>TUBULARS</u>	<u>Tool Type</u>	<u>Joints</u>	<u>Size</u>	<u>Weight</u>	<u>Grade</u>	<u>Thread</u>	<u>Top D</u>	<u>Bottom D</u>
SURFACE CASING								
	Casing	24	9.63	36.00	J-55	LTC	6	979
	Casing Float Collar	1	9.63		J-55		979	980
	Casing	1	9.63	36.00	J-55	LTC	980	1020
	Casing Guide Shoe	1	9.63		J-55		1020	1021
BRIDGE PLUG								
	Cast Iron Bridge Plu	1	9.73				80	83
<u>CEMENT JOBS</u>	<u>Stage</u>	<u>Sacks</u>	<u>Cement Jobs</u>			<u>Top D</u>	<u>Btm D</u>	<u>cbl</u>
SURFACE CASING								
	PRIM CMT 1ST STAGE	400	TAIL	FRESH WATER		6	1021	No
<u>PERFORATIONS</u>								
<u>Formation</u>	<u>Zone</u>	<u>Top</u>	<u>Btm</u>	<u>Date</u>	<u>Reason</u>	<u>Comments</u>		

Comments: