

T12S, R89W, 6th P.M.

GUNNISON ENERGY CORPORATION


Well location, (AS-DRILLED) DGU 1289 FEDERAL 18CS2, located as shown in the SE 1/4 NW 1/4 of Section 18, T12S, R89W, 6th. P.M., Gunnison County, Colorado.

BASIS OF ELEVATION

SPOT ELEVATION LOCATED IN THE NE 1/4 OF SECTION 9, T11S, R90W, 6th P.M. TAKEN FROM THE BULL MOUNTAIN QUADRANGLE, COLORADO, GUNNISON COUNTY, 7.5 MINUTE SERIES (TOPOGRAPHICAL MAP) PUBLISHED BY THE UNITED STATES DEPARTMENT OF THE INTERIOR, GEOLOGICAL SURVEY. SAID ELEVATION IS MARKED AS BEING 7487 FEET.

BASIS OF BEARINGS

BASIS OF BEARINGS IS A G.P.S. OBSERVATION.

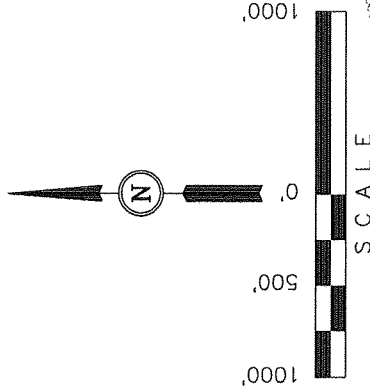

CERTIFICATE

THIS IS TO CERTIFY THAT THE ABOVE PLAT WAS PREPARED FROM FIELD NOTES OF ACTUAL SURVEYS MADE BY ME OR UNDER MY SUPERVISION AND THAT THE SAME ARE TRUE AND CORRECT TO THE BEST OF MY KNOWLEDGE AND BELIEF.

Harold Macdonald
REGISTERED LAND SURVEYOR
REGISTRATION NO. 1910
STATE OF COLORADO, 10-10-14

UINTAH ENGINEERING & LAND SURVEYING

85 SOUTH 200 EAST - VERNAL, UTAH 84078

(435) 789-1017

SCALE 1" = 1000'	DATE SURVEYED: 09-23-14	DATE DRAWN: 10-01-14
PARTY BRIAN BAKER T.C.	REFERENCES G.L.O. PLAT	
WEATHER SUNNY	FILE	
		GUNNISON ENERGY CORPORATION

PDOP = 1.4

NAD 83 (SURFACE LOCATION)
LATITUDE = 39°01'01.67" (39.017131)
LONGITUDE = 107°22'41.37" (107.378158)
NAD 27 (SURFACE LOCATION)
LATITUDE = 39°01'01.71" (39.017142)
LONGITUDE = 107°22'39.18" (107.377550)
UTM COORD.: NAD 1927 ZONE 13
N: 14177007.46 E: 965076.41

LEGEND:

- └─┘ = 90° SYMBOL
- = PROPOSED WELL HEAD.
- ▲ = SECTION CORNERS LOCATED.

