

Noble Energy, INC  
MERRIL # 1  
05-123-05617

**Current Wellbore Schematic**

Status - DA  
KB elev - 4873'  
GL elev - 4863'


25 sk cmt plug set @ surface

10 3/4" sur csg set @ 297'  
w/ 79 sks of cmt

Deepest Water well: 300'

Base Fox Hills 669'

NO PROD CSG  
open hole to TD

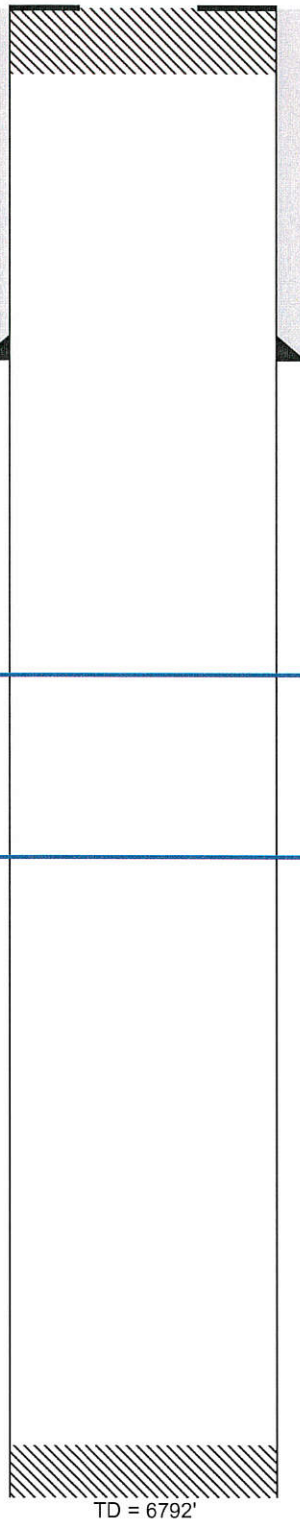

75 sk cmt plug set @ 6792'