

**KERR-MCGEE OIL AND GAS ONSHORE LP**

**SEKICH FARMS 19-7L**

**SW NE 19 3N 67W -- --**

**WELD,COLORADO**

**11/13/2014**

**AREA: N2**

**ROUTE: N27 Spud: 07/30/1993**

**WINS No.: H5080**

**AFE/WO#: 2102036**

**API#: 0512317153**

**GL: 4900**

**KB: 4913**

**MTD: 7370**


**TVD: 7370**

**LOG MD:**

**PBMD: 7285**

**PBTVD:**

**Directions: CR 32 & CR 13, E 6/10, S 4/10, W INTO. NEXT TO POND**

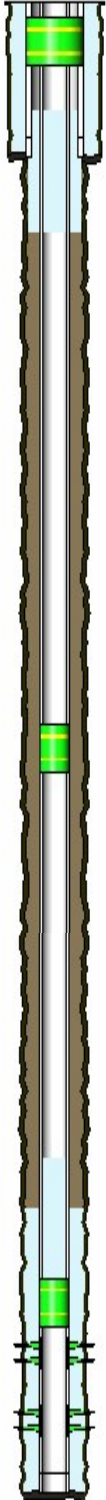

<u>HOLE SECTIONS</u>	<u>Size</u>	<u>Top</u>	<u>Btm</u>	<u>TD Date</u>					
SURFACE	12.25	13	520	07/30/1993					
PRODUCTION	7.88	520	7355	08/05/1993					
<u>TUBULARS</u>	<u>Tool Type</u>	<u>Joints</u>	<u>Size</u>	<u>Weight</u>	<u>Grade</u>	<u>Thread</u>	<u>Top D</u>	<u>Bottom D</u>	
SURFACE CASING	Casing	12	8.62	23.00	M-50		13	512	
	Casing	1	8.62				512	514	
PRODUCTION CASING	Casing	174	4.50	11.60	WC-75		13	7337	
	Casing	1	4.50				7337	7339	
BRIDGE PLUG	Cast Iron Bridge Plu	1	4.50				6920	6921	
CAST IRON CEMENT RETAINER	Cement Retainer	1	4.50				3896	3898	
BRIDGE PLUG	Cast Iron Bridge Plu	1	8.63				80	83	
<u>CEMENT JOBS</u>	<u>Stage</u>	<u>Sacks</u>	<u>Cement Jobs</u>				<u>Top D</u>	<u>Btm D</u>	<u>cbl</u>
SURFACE CASING		320	LEAD	TYPE 2			13	514	No
PRODUCTION CASING	PRIM CMT 1ST STAGE	160	LEAD				6498	7339	No
PRODUCTION CASING	ABANDONMENT PLUC	45	LEAD	CEMENT			6200	6920	No
CAST IRON CEMENT RETAINER	ABANDONMENT PLUC	160	LEAD	FRESH WATER			3700	4250	No
SURFACE CASING	ABANDONMENT PLUC	210	LEAD	FRESH WATER			580	960	No
SURFACE CASING	ABANDONMENT PLUC	80	LEAD	FRESH WATER			360	580	No
<u>PERFORATIONS</u>									
<u>Formation</u>	<u>Zone</u>	<u>Top</u>	<u>Btm</u>	<u>Date</u>	<u>Reason</u>	<u>Comments</u>			
		3855	3856	10/20/2014	CEMENT SQUEEZE				
		4250	4251	10/20/2014	CEMENT SQUEEZE				
NIOBRARA		6978	7101	11/12/2004	PRODUCTION				
CODELL		7218	7236	08/08/1993	PRODUCTION				

**Comments:**