

Ferguson #1 F-4 As Plugged 9/26/14

Red Mesa Field

2130' FSL & 100' FEL, Section 33, T-33-N, R-12-W, La Plata County, CO

Lat: N 37.05893 / Long: W -10.14677 / API #05-067-06133

Today's Date: 5/30/14
Spud: 4/12/77
Completed: 8/20/77
Elevation: 6515' GI

Cliff House @ 435' *est


Point Lookout @ 1005' *est

Gallup @ 2559' *est

Dakota @ 3400' *est

12" hole

7-7/8" hole

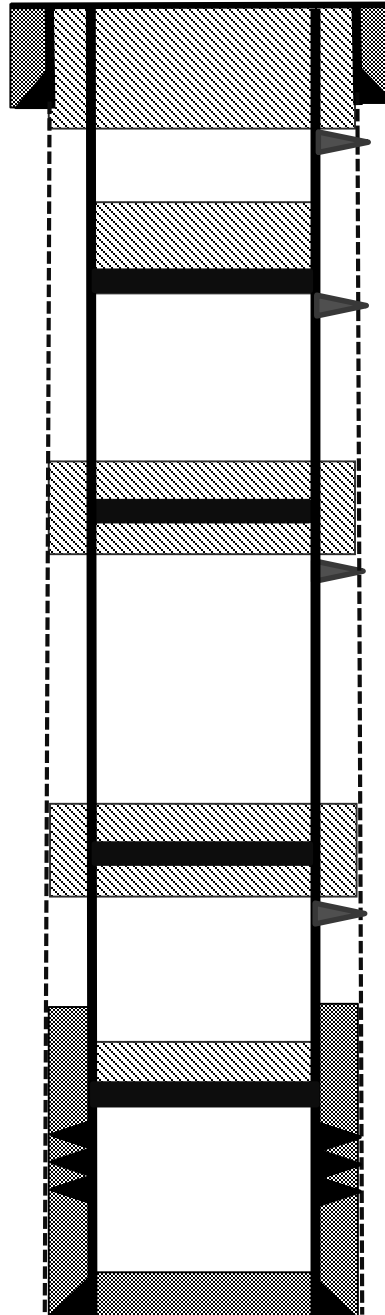

10-3/4" 32#, Casing set @ 49'
Cement with 3 yds Redi Mix

Perforate @ 200'

Set CR @ 438'

Perforate @ 485'

Set CR @ 1005'

Perforate @ 1055'

Set CR @ 2559'

Perforate @ 2609'

TOC @ 3290' *est

Set CR @ 3226'

Dakota Perforations:
3438' - 3480'

4-1/2" 10.5#, Casing set @ 3524'
Cement with 60 sxs

Plug #6: Surface and P&A Marker
Class B cement, 12 sxs

Plug #5: 200' - 0'
Class B cement, 143 sxs

Plug #4: 485' - 227'
Class B cement, 16 sxs
with 2% CaCl₂.

Plug #3: 1055' - 987'
Class B cement, 55 sxs:
16 inside and 39 outside
Tagged low.
Plug #3A Spot 12 sxs
inside casing from 987' to
829'

Plug #2: 2609' - 2401'
Class B cement, 55 sxs:
16 inside and 39 outside

Plug #1: 3226' - 2909'
Class B cement, 24 sxs
with 2% CaCl₂

TD 3590'
PBSD 3410'