




Lease Name: Howard 2-27

Legals: NWNE 27 6N 64W

County: Weld County, Colorado

API#: 05-123-13325

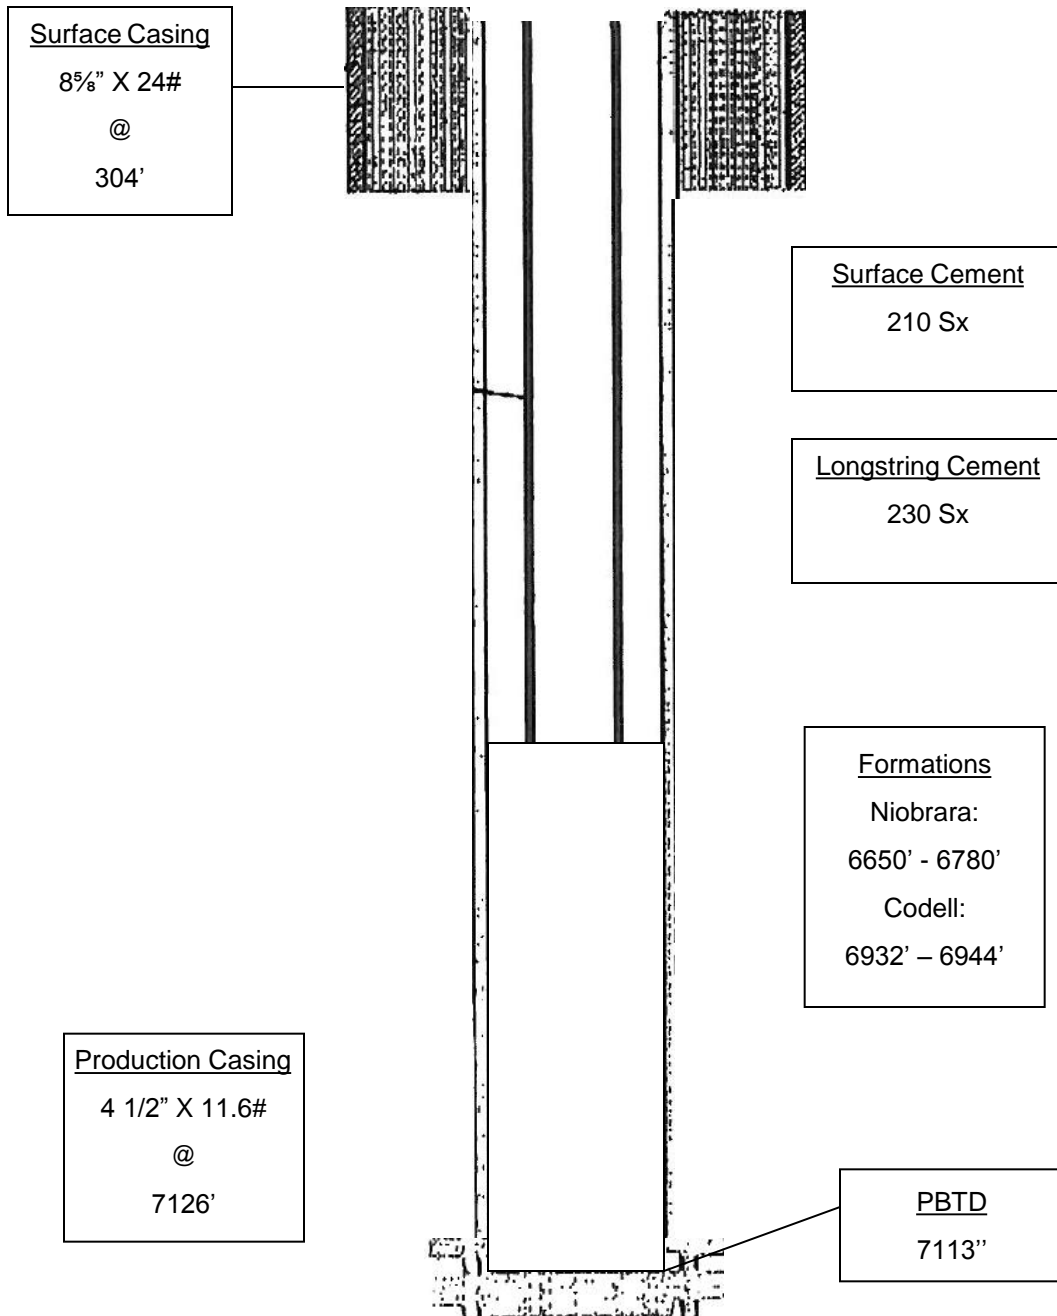

Wellbore Diagram