Well Name: Pfeiffer 9-26
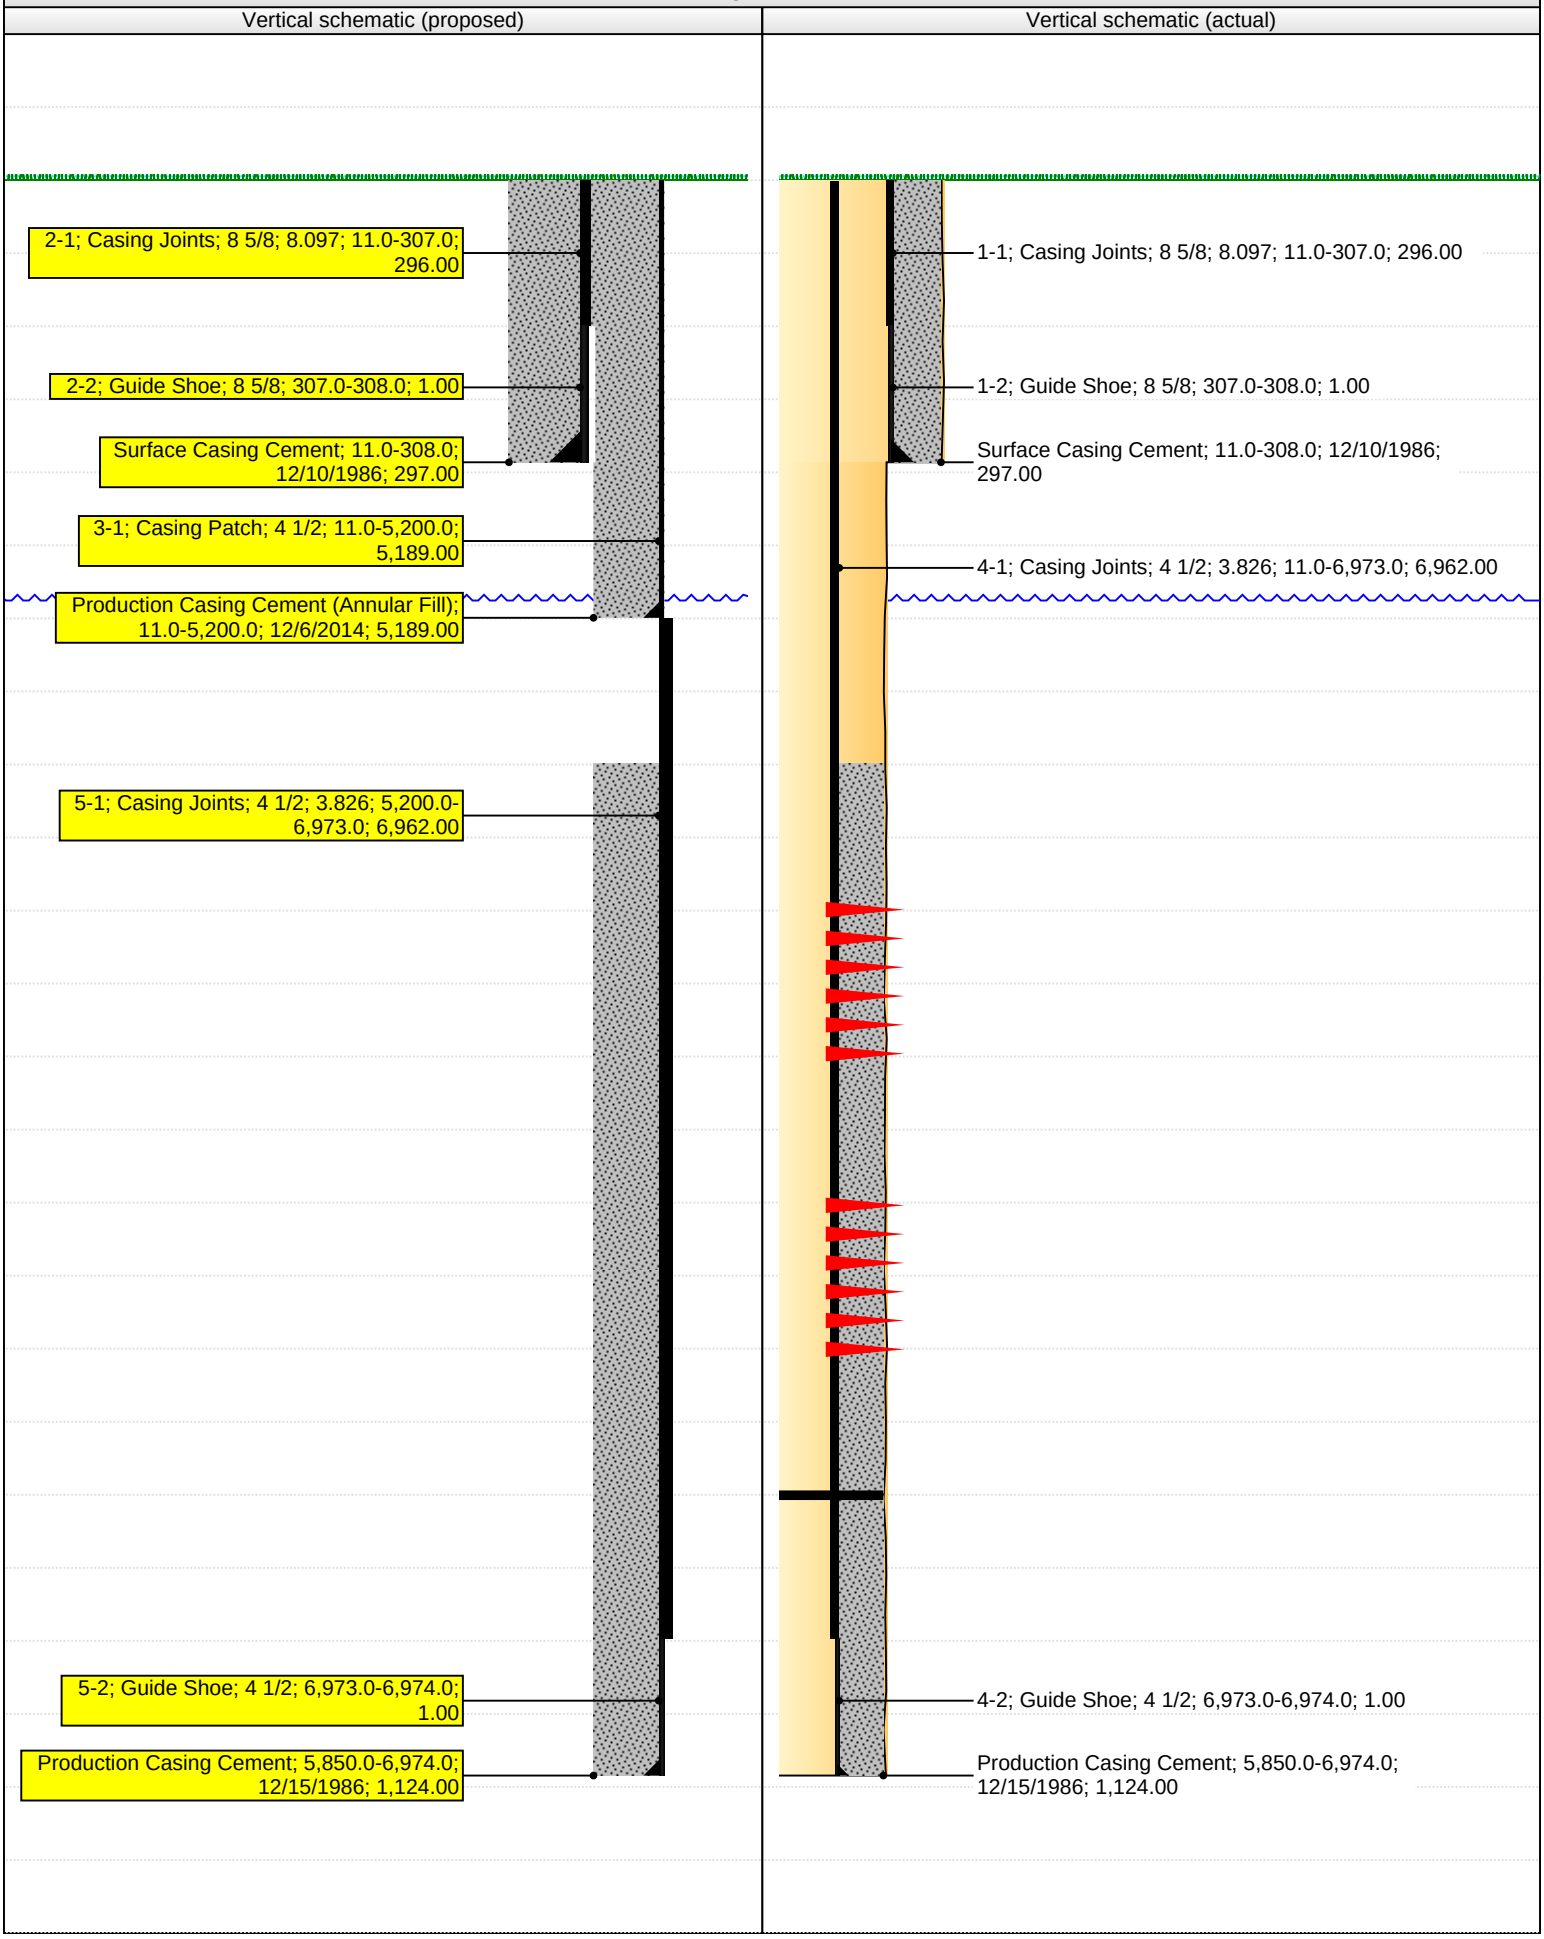
Vertical - Original Hole, 12/6/2014