


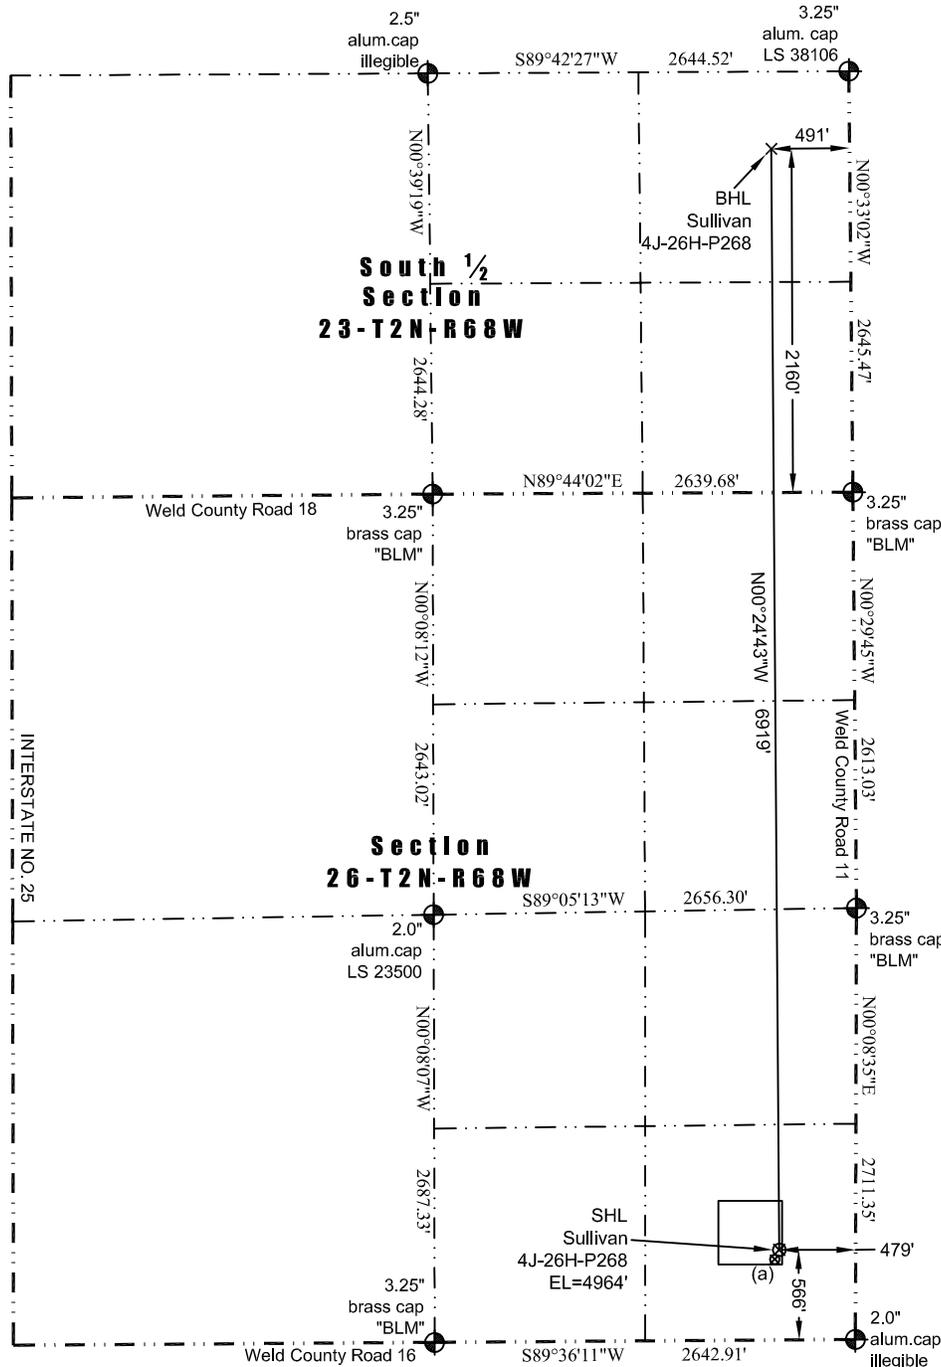

WELL LOCATION CERTIFICATE

THIS MAP DOES NOT REPRESENT A BOUNDARY SURVEY

Washburn Land Surveying
www.WashburnSurveying.com
970-232-9645



LEGEND
 ◆ - found survey monument
 (C) - calculated dimension

(a) Existing Well Data:
 Sullivan 44-26
 Latitude: N 40.103812°
 Longitude: W 104.962807°
 FSL: 556'
 FEL: 514'
 ELEV: 4964'
 PDOP: 1.8

Proposed Surface Hole Data:
 Latitude: N 40.103839° (BHL: 40.122833°)
 Longitude: W 104.962682° (BHL: 104.962710°)
 PDOP: 1.5

Nearest:
 Building: 591' northeast
 Building Unit: 637' northeast
 Above Ground Utility: 410 east
 Public Road: 460' east
 Railroad: +5,280'
 Property Line: 269' northwest
 Well Window: SHL is 18' inside
 Existing Well: Sullivan 44-26; 36' southwest
 High Occupancy Building Unit: 3,057 northwest


In accordance with a request from Jay Knutson of EnCana Oil & Gas (USA) Inc., Washburn Land Surveying, LLC has determined the location of the **Sullivan 4J-26H-P268** well site to be SHL: 566' FSL and 479' FEL, (BHL: 2160' FSL and 491' FEL), as measured at ninety (90) degrees from the section lines of Section 23 and Section 26, Township 2 North, Range 68 West of the 6th Principal Meridian, Weld County Colorado.

Notes:

- 1) Bearings and distances based on NAD 83 Colorado North State Plane Coordinate, using RTK GPS observations taken 7/7/14 by operator Ryan Christi.
- 2) Conversion factor to ground (1.0002744738).
- 3) Elevations based on NAVD 88 GPS heights and Geoid 2009 corrections.
- 4) See Location Drawing for visible improvements within 500 feet of Pad Site.
- 5) The surface use is a cultivated field.

NOTICE: According to Colorado law you must commence any legal action based upon any defect in this W.L.C. within three years after you first discover such defect. In no event may any action based upon any defect in this W.L.C. be commenced more than ten years from this said date of the certification shown hereon.

I hereby certify that this Well Location Certificate was prepared by me or under my direct supervision on 7/31/2014 for and on behalf of EnCana Oil & Gas (USA) Inc. That it is not a Land Survey Plat or an Improvement Survey Plat and that it is not to be relied upon for establishment of fences, buildings, or other future improvement lines.

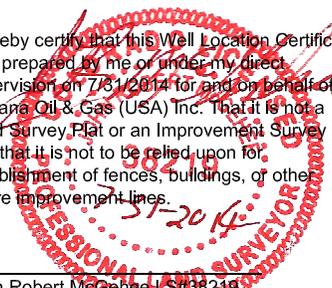

John Robert McGehee L.S.#38219
 Well: Sullivan 4J-26H-P268 WLC