

1625 Broadway  
Suite 2000  
Denver, CO 80202



Tel: 303.228.4000  
Fax: 303.228.4280  
www.nobleenergyinc.com

November 19, 2014

Colorado Oil and Gas Conservation Commission  
The Chancery Building  
1120 Lincoln Street, Suite 801  
Denver, CO 80203  
Attn: Mr. Matt Lepore, Director

RE: Aggie State AA17-625  
Section 17: Township 6 North, Range 63 West, 6th P.M.  
Weld County, Colorado

Dear Director:

Noble Energy, Inc. ("NEI") is planning to drill the captioned boundary well in accordance with the provisions of COGCC Rule 318A.e.

NEI's proposed wellbore spacing unit consists of the Sec 16: W/2SW/4, Sec 17: S/2, T6N, R63W, creating a 400-acre wellbore spacing unit for the Niobrara formation. NEI is the only owner within the proposed wellbore spacing unit, therefore NEI hereby attests that no notice letters are required under COGCC Rule 318A(l).e.(6).

Enclosed are copies of the following documents to assist you in your review and approval of NEI's proposed APD for the captioned well:

- Map & plat illustrating proposed wellbore spacing unit.

Thank you for your attention to the enclosed. NEI respectfully requests that the COGCC review the enclosed information and approve the Application for Permit to Drill the captioned well.

Sincerely,

Justin Garrett  
Regulatory Analyst II  
Noble Energy Inc.






Lat40, Inc. 6250 W. 10th Street, Unit 2, Greeley, CO 970-515-5294

# WELL LOCATION CERTIFICATE


THIS MAP DOES NOT REPRESENT A BOUNDARY SURVEY

SECTION: 17  
TOWNSHIP: 6N  
RANGE: 63W

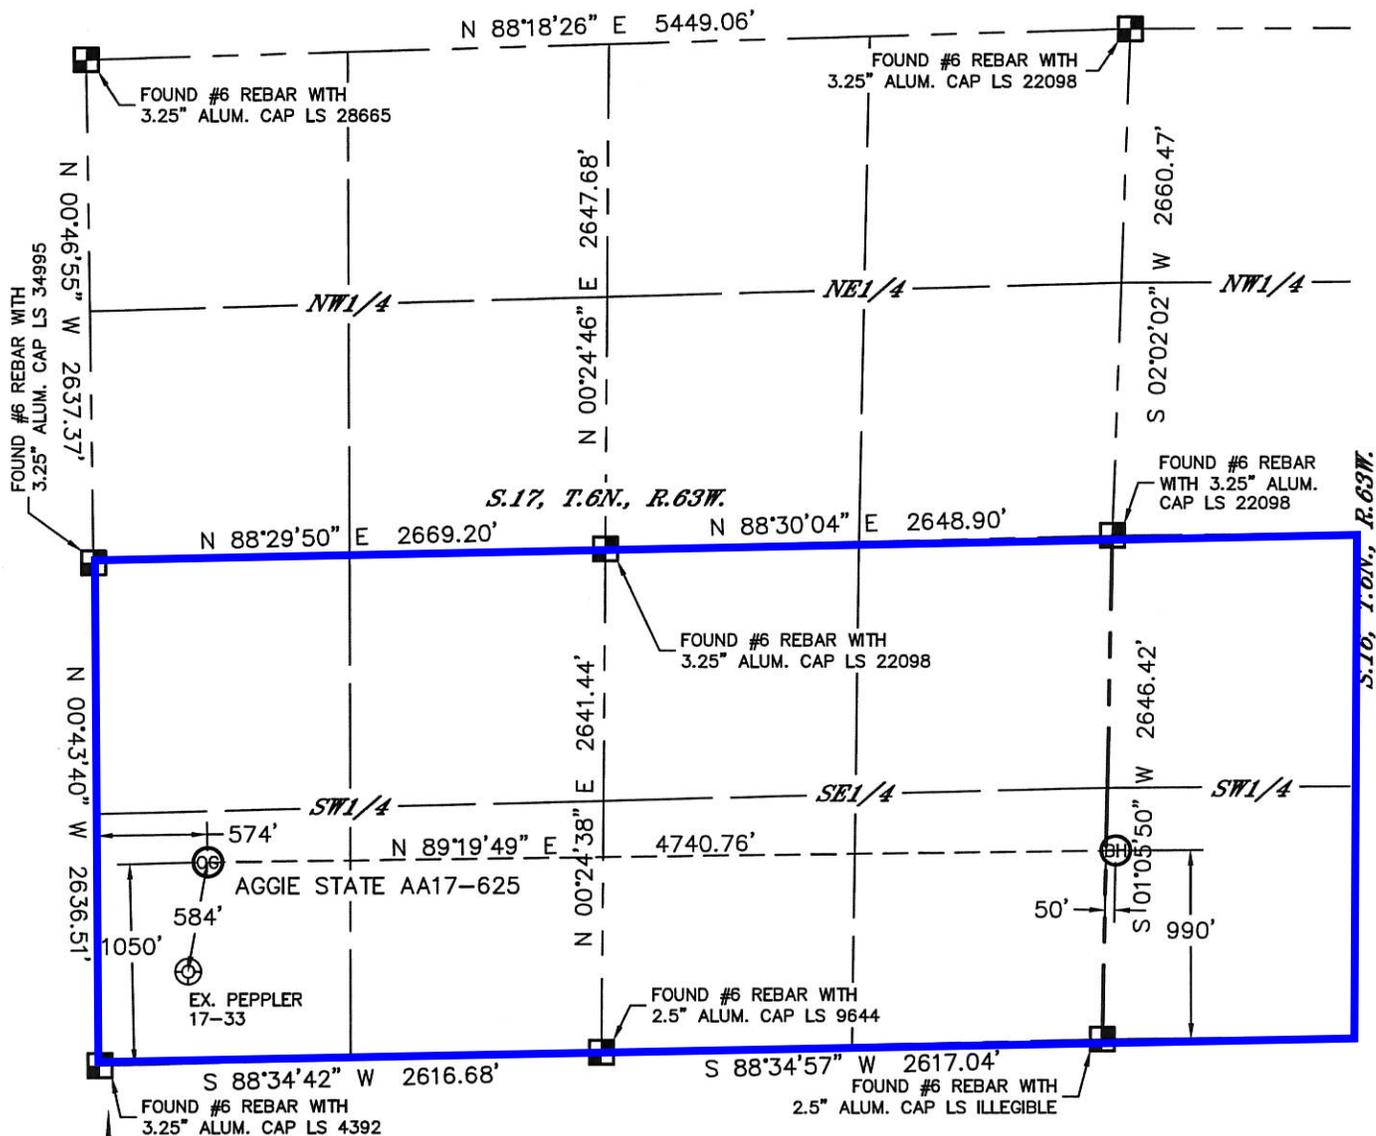

In accordance with a request from Greg Wilson with Noble Energy Inc. Lat40, Inc. has determined the surface location of the AGGIE STATE AA17-625 to be 1050' from the SOUTH line and 574' from the WEST line as measured at right angles from the section lines of Section 17, Township 6 North, Range 63 West and the bottom hole to be 990' from the SOUTH line and 50' from the WEST line as measured at right angles from the section lines of Section 16, Township 6 North, Range 63 West of the Sixth Principal Meridian, County of Weld, State of Colorado.

I hereby state that this Well Location Certificate was prepared by me, or under my direct supervision, that the fieldwork was completed on 7/24/2014, for and on behalf of Noble Energy Inc. That this is not a Land Survey Plat or an Improvement Survey Plat, and that it is not to be relied upon for establishment of fence, building, or other future improvement lines.

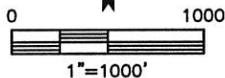

NOTE:

- 1) Bearings shown are Grid Bearings of the Colorado State Plane Coordinate System, North Zone, North American Datum 1983. The lined dimensions as contained herein are based upon the "U.S. Survey Foot."
  - 2) Ground elevations are based on an observed GPS elevation (NAVD 1988 DATUM).
  - 3) IMPROVEMENTS: See LOCATION DRAWING for all visible improvements within 500' of disturbed area.
  - 4) SURFACE USE: CROP LAND
  - 5) INSTRUMENT OPERATOR: WYATT HALL
  - 6) NEAREST EXISTING WELL: PEPPLER 17-33, ±584' SW
- NEAREST CULTURAL ITEMS:  
 BUILDING: ±1387' SW  
 BUILDING UNIT: ±1387' SW  
 HIGH OCCUPANCY BUILDING UNIT: 5280'+  
 DESIGNATED OUTSIDE ACTIVITY AREA: 5280'+  
 PUBLIC ROAD: ±1037' S (CR 68)  
 ABOVEGROUND UTILITY: ±1038' SW  
 RAILROAD: 5280'+  
 PROPERTY LINE: ±574' W

**SURFACE LOCATION**  
 LAT: 40.48215N  
 LONG: 104.46826W  
 PDOP: 1.7  
 ELEV: 4666'  
 1/4,1/4: SWSW

**BOTTOM HOLE**  
 LAT: 40.48215N  
 LONG: 104.45122W


LEGEND

- = ALIQUOT MONUMENT AS DESCRIBED
- = CALCULATED POSITION

SHEET 1 OF 2

Kyle E. Rutz-On behalf of Lat40, Inc.  
 Colorado Licensed Professional Land Surveyor  
 Land Surveyor No. 38307

DATE: 8/22/2014  
 PROJECT#: 2013082

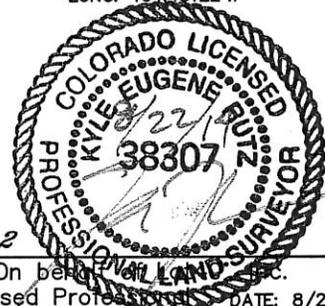





Lat40°, Inc. 6250 W. 10th Street, Unit 2, Greeley, CO 970-515-5294

# WELL LOCATION CERTIFICATE

THIS MAP DOES NOT REPRESENT A BOUNDARY SURVEY

SECTION: 17  
TOWNSHIP: 6N  
RANGE: 63W

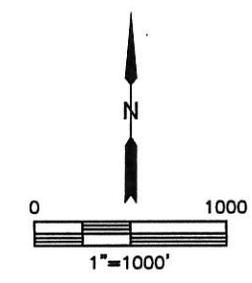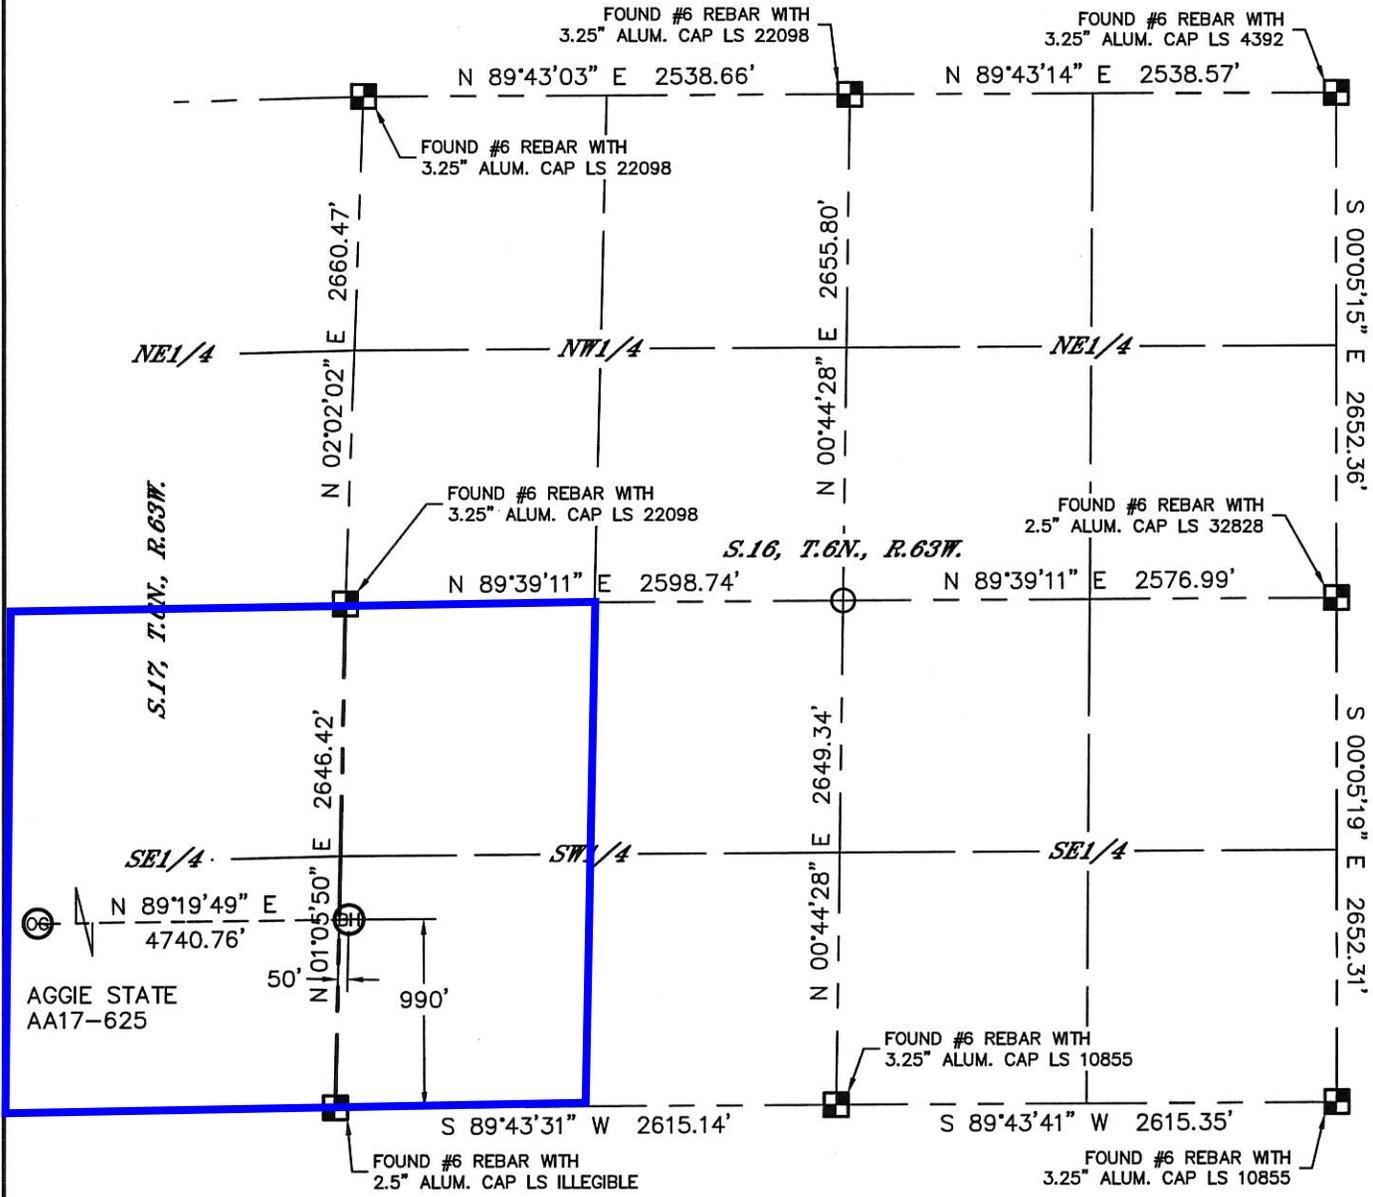

- LEGEND
- = ALIQUOT MONUMENT AS DESCRIBED
  - = CALCULATED POSITION

SHEET 2 OF 2

Kyle E. Rutz-On behalf of RUTZ & ASSOCIATES, P.C.  
Colorado Licensed Professional Land Surveyor No. 38307

DATE: 8/22/2014  
PROJECT#: 2013082

