


LONE MOUNTAIN PRODUCTION COMPANY
 WELLBORE DIAGRAM
 FEDERAL NO. 19-4
 NW¹/₄ NW¹/₄ SEC 19, T1S-R103W
 39.95077°N 109.00348°W
 RIO BLANCO COUNTY, COLORADO
 LEASE NO. COC-56301

Post-Abandonment Conditions

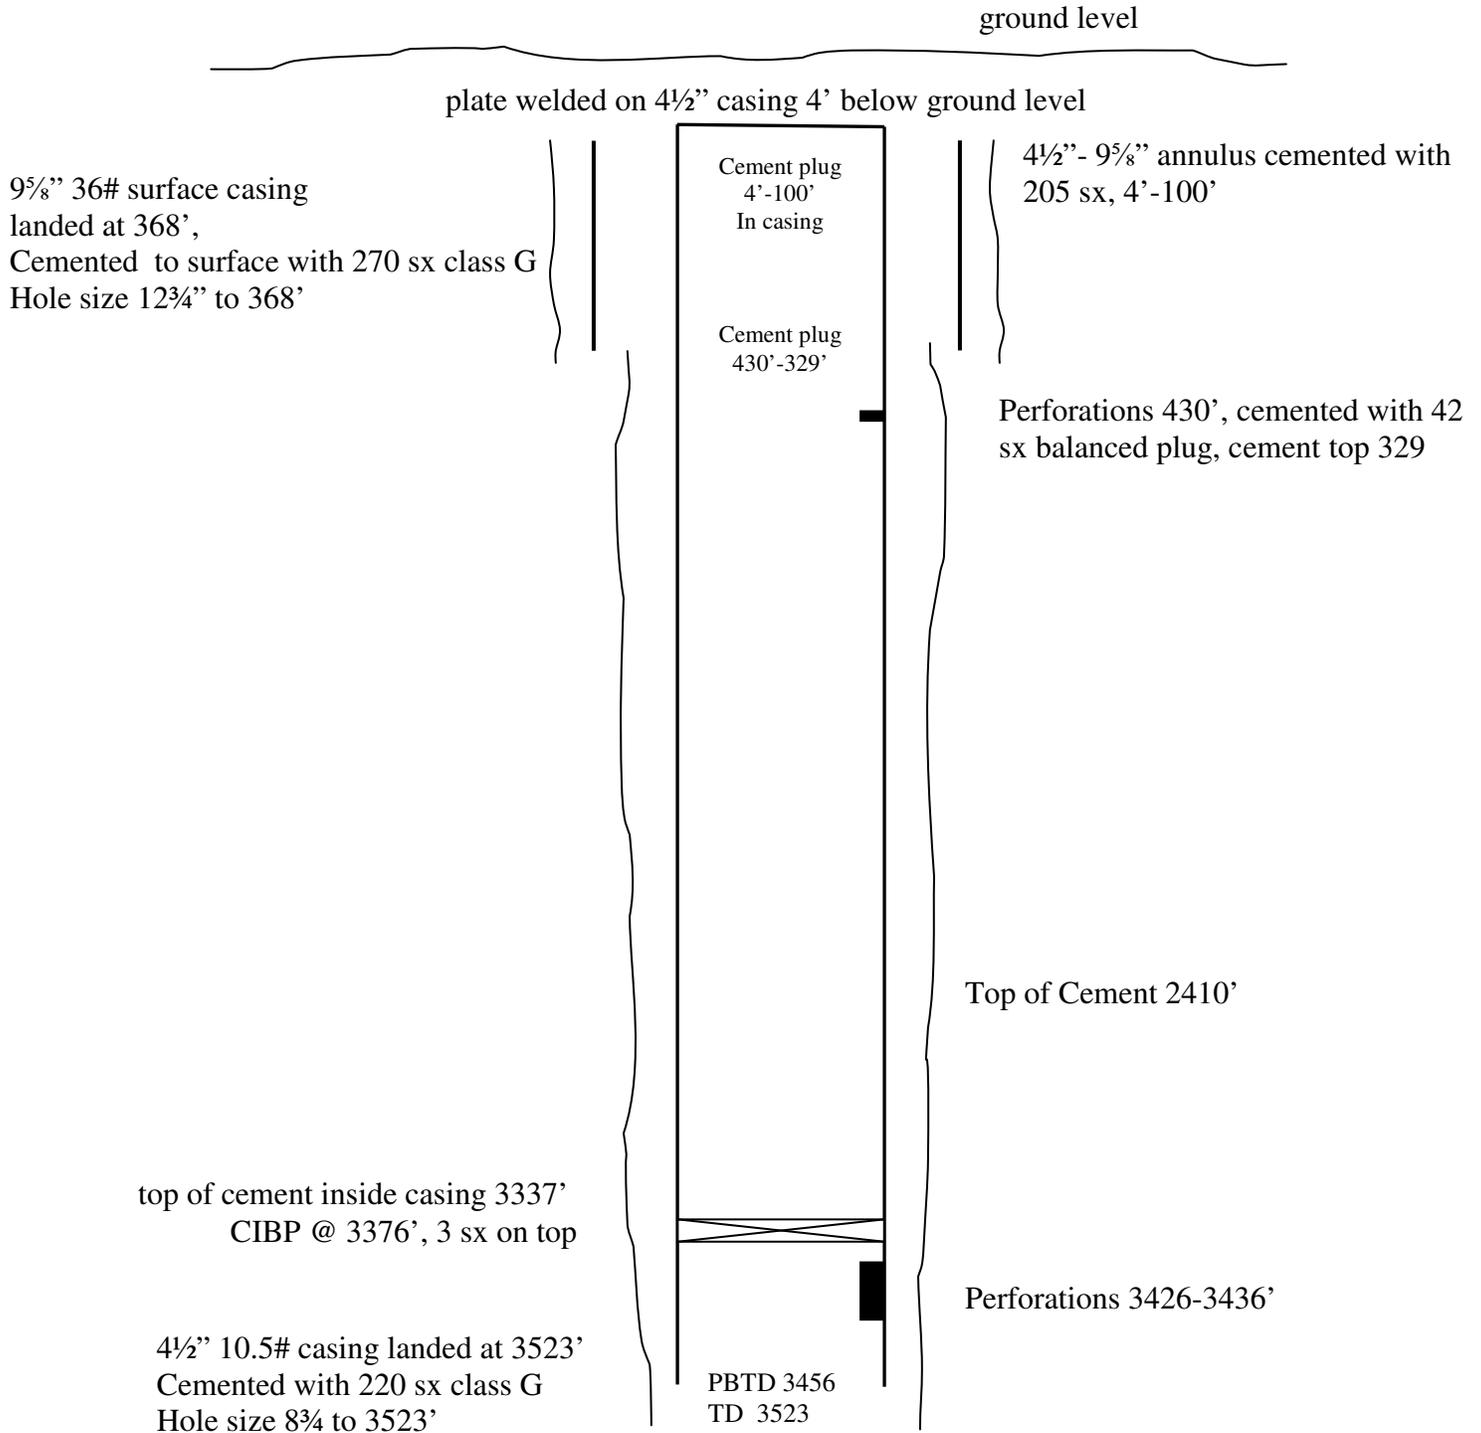

Not to scale

Updated 07/10/2014