




Lat40°, Inc. 6250 W. 10th Street, Unit 2, Greeley, CO 970-515-5294

ACCESS ROAD MAP

C-10 PAD

SECTION: 35
TOWNSHIP: 7N
RANGE: 65W

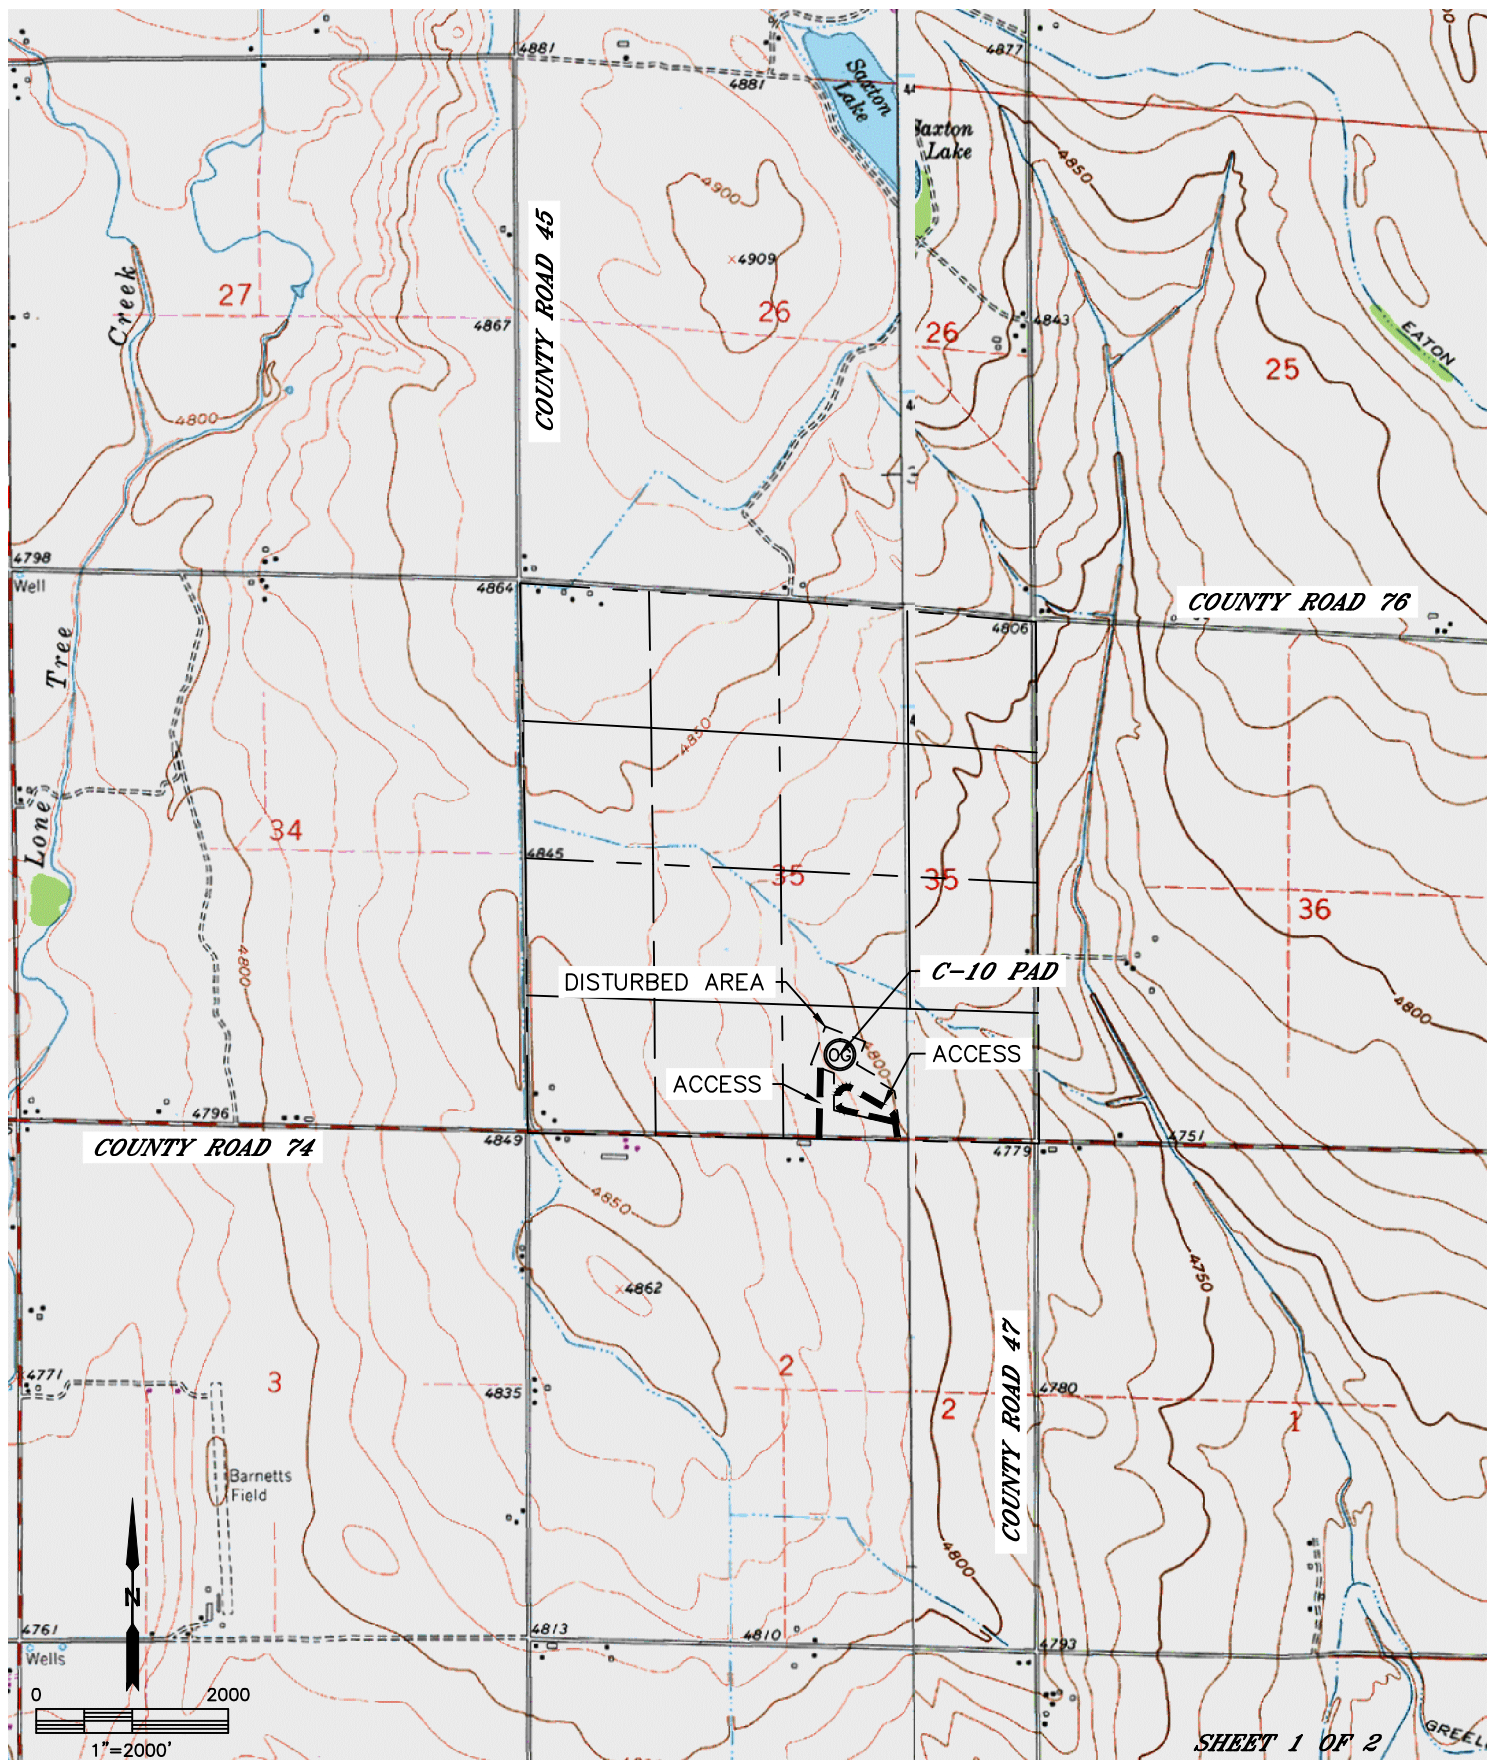

SHEET 1 OF 2

DATE: 11/24/2014
PROJECT#: 2014178





Lat40°, Inc. 6250 W. 10th Street, Unit 2, Greeley, CO 970-515-5294

ACCESS ROAD MAP

C-10 PAD

SECTION: 35
TOWNSHIP: 7N
RANGE: 65W

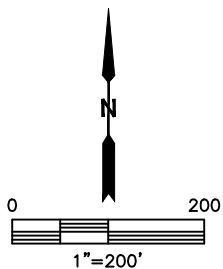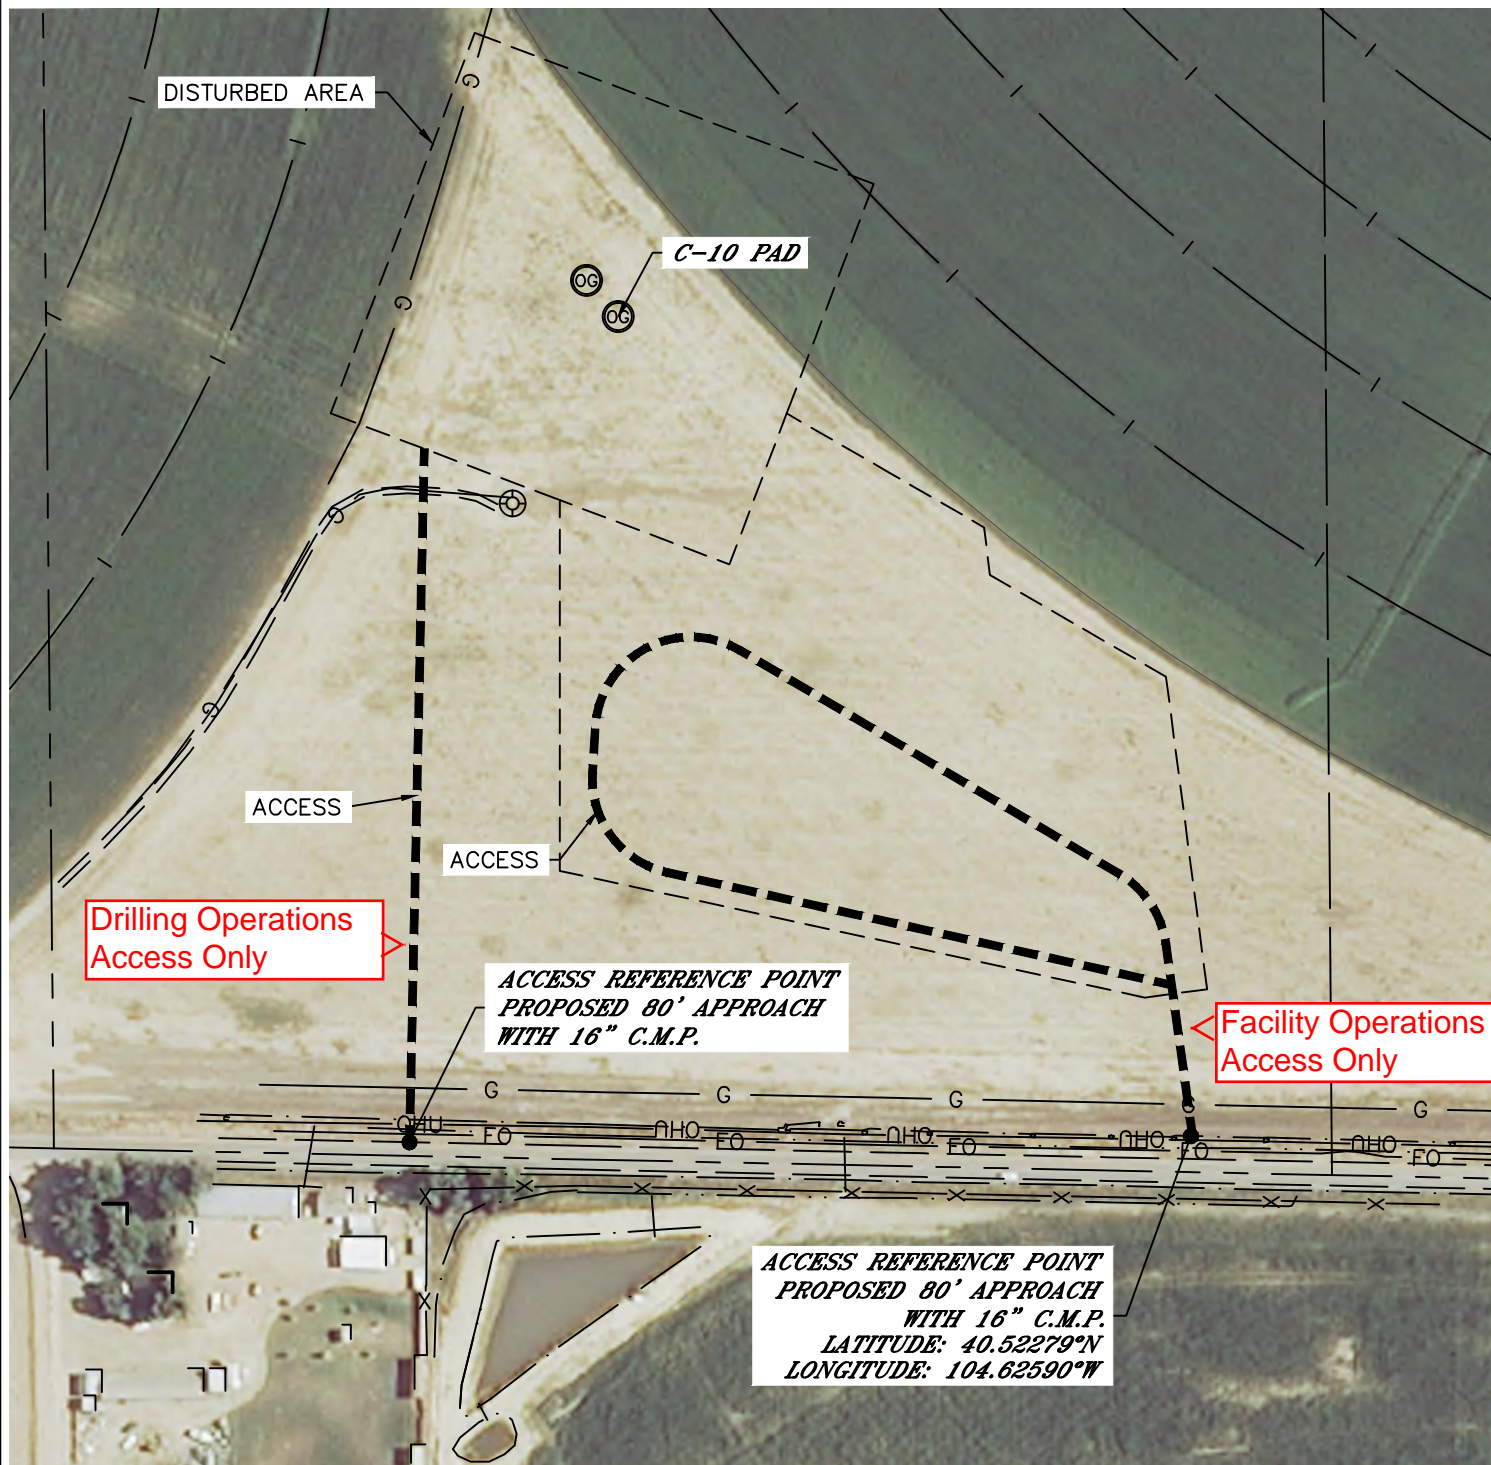

SHEET 2 OF 2

DATE: 11/24/2014
PROJECT#: 2014178




Lat40°, Inc. 6250 W. 10th Street, Unit 2, Greeley, CO 970-515-5294

ACCESS PICTURES


C-10 PAD

SECTION: 35
TOWNSHIP: 7N
RANGE: 65W

DATE: 10/3/2014

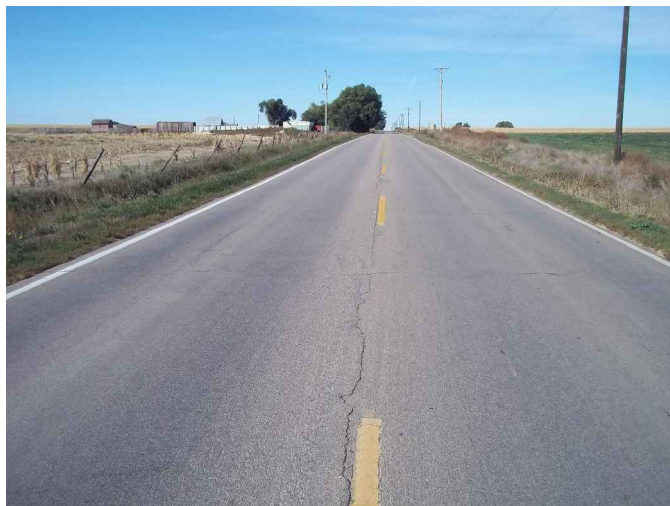

VIEW WEST (CR-74)

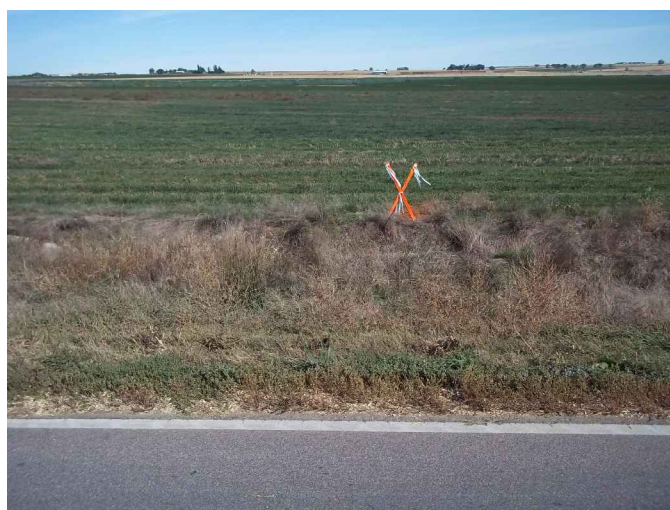

VIEW NORTH



VIEW EAST (CR 74)

SHEET 3 OF 3

DATE: 10/8/2014
PROJECT#: 2014178