

KERR-MCGEE OIL AND GAS ONSHORE LP

NESG 14-24

SW SW 24 3N 68W 368' FSL 274' FWL

WELD, COLORADO

11/24/2014

AREA: W2

ROUTE: W22 Spud: 03/14/2008

WINS No.: 93360

AFE/WO#: 88594714

API#: 0512324977

GL: 4954

KB: 4974

MTD: 7476


TVD: 7279

LOG MD: 4500

PBMD: 7655

PBTVD: 7477

Directions: HWY 66 & WCR 11; EAST 1/10 MILE; NORTH INTO

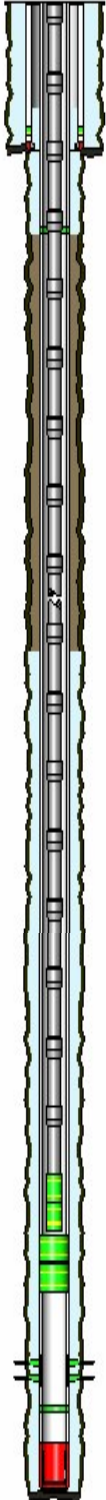

<u>HOLE SECTIONS</u>	<u>Size</u>	<u>Top</u>	<u>Btm</u>	<u>TD Date</u>
SURFACE	12.25	25	920	03/15/2008
PRODUCTION	6.50	920	7700	03/20/2008

<u>TUBULARS</u>	<u>Tool Type</u>	<u>Joints</u>	<u>Size</u>	<u>Weight</u>	<u>Grade</u>	<u>Thread</u>	<u>Top D</u>	<u>Bottom D</u>
SURFACE CASING								
	Casing	19	8.63	24.00	J-55	STC	25	871
	Baffle	1	8.63				871	871
	Casing	1	8.63	24.00	J-55	STC	871	916
	Casing Guide Shoe	1	8.63				916	917
PRODUCTION CASING								
	Casing	32	4.50	11.60	I-80	LTC	20	1424
	Cement Stage Too	1	4.50		L-80		1424	1427
	Casing	175	4.50	11.60	I-80	LTC	1427	7655
	Latch Down Baffle	1	4.50				7655	7655
	Casing	1	4.50	11.60	I-80	LTC	7655	7678
	Casing Float Shoe	1	4.50				7678	7680
BRIDGE PLUG								
	Cast Iron Bridge Plu	1	4.50				7184	7185
BRIDGE PLUG								
	Cast Iron Bridge Plu	1	4.50				7199	7200
PRODUCTION TUBING								
	Tubing	226	2.38	4.70	J-55	External-Ups	20	7155
	XN Profile Nipple	1	2.38				7155	7156
	Notched Collar	1	2.38				7156	7156

<u>CEMENT JOBS</u>	<u>Stage</u>	<u>Sacks</u>	<u>Cement Jobs</u>	<u>Top D</u>	<u>Btm D</u>	<u>cbl</u>
SURFACE CASING						
	PRIM CMT 1ST STAGE	340	LEAD 50/50 POZ-MIX	20	645	No
	PRIM CMT 1ST STAGE	100	TAIL TYPE 2	645	917	No
PRODUCTION CASING						
	PRIM CMT 1ST STAGE	110	LEAD 50/50 POZ-MIX	3500	4700	Yes
	PRIM CMT 1ST STAGE	58	MIDDLE HLC EXTREME LITE	4700	6840	Yes
	PRIM CMT 1ST STAGE	80	TAIL HLC	6840	7680	Yes
PRODUCTION CASING						
	REMEDIAL CEMENT	75	LEAD CEMENT	658	1430	Yes

<u>PERFORATIONS</u>						
<u>Formation</u>	<u>Zone</u>	<u>Top</u>	<u>Btm</u>	<u>Date</u>	<u>Reason</u>	<u>Comments</u>
CODELL		7517	7531	04/01/2008	PRODUCTION	

Comments: