

KERR-MCGEE OIL AND GAS ONSHORE LP
STIEBER, GEORGE W UNIT 1
SE SW 24 1N 67W -- --
WELD, COLORADO
12/02/2014

AREA: W3

ROUTE: W34 Spud: 12/11/1973

WINS No.: 73786

AFE/WO#: 2102128

API#: 0512307935

GL: 4938

KB: 4948

MTD: 8190


TVD: 8190

LOG MD:

PBMD: 8136

PBTVD: 8136

Directions: CR 6 & CR 23, E 6/10, N 2/10, W 3/10 INTO. SLOW PAST FARM HOUSES

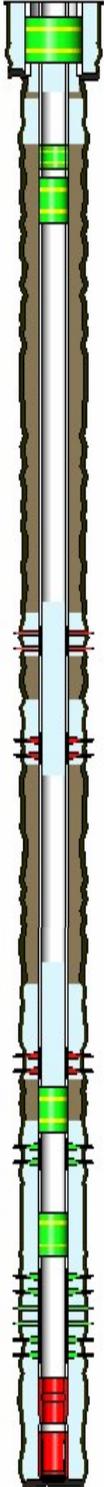

<u>HOLE SECTIONS</u>	<u>Size</u>	<u>Top</u>	<u>Btm</u>	<u>TD Date</u>				
SURFACE	12.25	10	206	12/11/1973				
PRODUCTION	7.88	206	8150	12/21/1973				
<u>TUBULARS</u>	<u>Tool Type</u>	<u>Joints</u>	<u>Size</u>	<u>Weight</u>	<u>Grade</u>	<u>Thread</u>	<u>Top D</u>	<u>Bottom D</u>
SURFACE CASING	Casing	7	8.63	24	K-55		10	205
PRODUCTION CASING	Casing	25	4.50	10.5	K-55	STC	10	801
	Cement Stage Too	1	4.50				801	803
	Casing	229	4.50	10.5	K-55	STC	803	8136
	Casing Float Collar	1	4.50				8136	8137
	Casing	1	4.50	11.6	K-55	STC	8137	8138
	Casing Guide Shoe	1	4.50				8138	8139
BRIDGE PLUG	Cast Iron Bridge Plu	1	4.50				7520	7522
BRIDGE PLUG	CIBP With CMT Cap	1	4.50				7970	7972
CAST IRON CEMENT RETAINER	Cement Retainer	1	4.50				884	886
BRIDGE PLUG	Cast Iron Bridge Plu	1	8.63				90	93
<u>CEMENT JOBS</u>	<u>Stage</u>	<u>Sacks</u>	<u>Cement Jobs</u>		<u>Top D</u>	<u>Btm D</u>	<u>cbf</u>	
SURFACE CASING	STAGE 1	200	REGULAR		10	206	No	
PRODUCTION CASING	STAGE 1	200	LEAD	CEMENT	7540	8136	Yes	
PRODUCTION CASING	PRIM CMT 2ND STAGE	200	LEAD	CEMENT	400	801	No	
PRODUCTION CASING	REMEDIAL CEMENT	150	LEAD	G	6890	7450	Yes	
	REMEDIAL CEMENT	250	LEAD-1	G	4710	5010	Yes	
	REMEDIAL CEMENT	150	LEAD-2	G	4240	4350	Yes	
PRODUCTION CASING	ABANDONMENT PLUC	50	LEAD	FRESH WATER	6700	7520	No	
PRODUCTION CASING	ABANDONMENT PLUC	60	LEAD	FRESH WATER	4465	5100	No	
PRODUCTION CASING	ABANDONMENT PLUC	40	LEAD	FRESH WATER	4150	4465	No	
SURFACE CASING	ABANDONMENT PLUC	150	LEAD	FRESH WATER	120	350	No	
CAST IRON CEMENT RETAINER	ABANDONMENT PLUC	450	LEAD	FRESH WATER	350	1505	No	
<u>PERFORATIONS</u>	<u>Formation</u>	<u>Zone</u>	<u>Top</u>	<u>Btm</u>	<u>Date</u>	<u>Reason</u>	<u>Comments</u>	
			860	861	10/27/2014	CEMENT SQUEEZE		
			1505	1506	10/27/2014	CEMENT SQUEEZE		
			4340	4341	11/27/1995	CEMENT SQUEEZE		
			5000	5001	11/27/1995	CEMENT SQUEEZE		
			7444	7445	11/27/1995	CEMENT SQUEEZE		
CODELL			7586	7608	12/08/1995	PRODUCTION		

KERR-MCGEE OIL AND GAS ONSHORE LP
STIEBER, GEORGE W UNIT 1
SE SW 24 1N 67W -- --
WELD,COLORADO
12/02/2014

AREA: W3 ROUTE: W34 Spud: 12/11/1973 WINS No.: 73786 AFE/WO#: 2102128 API#: 0512307935

GL: 4938 KB: 4948 MTD: 8190 TVD: 8190 LOG MD: PBMD: 8136 PBTVD: 8136

Directions: CR 6 & CR 23, E 6/10, N 2/10, W 3/10 INTO. SLOW PAST FARM HOUSES

J SAND	8040	8046	01/28/1974	PRODUCTION
J SAND	8054	8064	01/28/1974	PRODUCTION
J SAND	8069	8081	01/28/1974	PRODUCTION

Comments: