

KERR-MCGEE OIL AND GAS ONSHORE LP

**WEBBER ELMER A 1
SW SW 10 3N 66W -- --
WELD,COLORADO
12/02/2014**

AREA: N1

ROUTE: N12 Spud: 12/09/1977

WINS No.: 76892

AFE/WO#: 2095824

API#: 0512309345

GL: 4856

KB: 4866

MTD: 7983


TVD: 7983

LOG MD:

PBMD: 7846

PBTVD: 7846

Directions: WCR 31 & WCR 34, E 2/10, N INTO

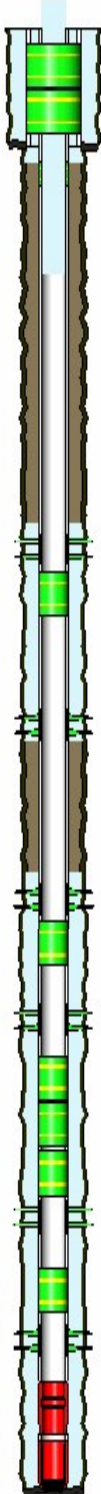

<u>HOLE SECTIONS</u>	<u>Size</u>	<u>Top</u>	<u>Btm</u>	<u>TD Date</u>
SURFACE	12.25	10	236	12/09/1977
PRODUCTION	7.88	236	7983	12/21/1977

<u>TUBULARS</u>	<u>Tool Type</u>	<u>Joints</u>	<u>Size</u>	<u>Weight</u>	<u>Grade</u>	<u>Thread</u>	<u>Top D</u>	<u>Bottom D</u>
SURFACE CASING	Casing	5	8.63	24	K-55	STC	10	235
PRODUCTION CASING	Casing	12	4.50	11.6	K-55	STC	10	402
	Cement Stage Too	1	4.50				402	407
	Casing	227	4.50	11.6	K-55	STC	407	7937
	Casing Float Collar	1	4.50				7937	7939
	Casing	1	4.50	11.6	K-55	STC	7939	7969
	Casing Guide Shoe	1	4.50				7969	7970
BRIDGE PLUG	Cast Iron Bridge Plu		4.50				7270	7272
BRIDGE PLUG	Cast Iron Bridge Plu		4.50				7730	7732
BRIDGE PLUG	Cast Iron Bridge Plu		4.50				7220	7222
BRIDGE PLUG	Cast Iron Bridge Plu		4.50				7190	7192
CAST IRON CEMENT RETAINER	Cement Retainer		4.50				6571	6573
CAST IRON CEMENT RETAINER	Cement Retainer		4.50				4051	4053
BRIDGE PLUG	Cast Iron Bridge Plu		8.63				105	107
BRIDGE PLUG	Cast Iron Bridge Plu		8.63				90	92

<u>CEMENT JOBS</u>	<u>Stage</u>	<u>Sacks</u>	<u>Cement Jobs</u>	<u>Top D</u>	<u>Btm D</u>	<u>cbl</u>
SURFACE CASING	STAGE 1	225	UNKNOWN	10	236	No
PRODUCTION CASING	PRIM CMT 1ST STAGE	250	LEAD-1 50/50 POZ	6960	7983	Yes
	PRIM CMT 2ND STAGE	200	LEAD-2 FRESH WATER	10	402	Yes
PRODUCTION CASING	ABANDONMENT PLUC	140	LEAD FRESH WATER	6375	6981	No
PRODUCTION CASING	ABANDONMENT PLUC	640	LEAD FRESH WATER	3855	5021	No
PRODUCTION CASING	ABANDONMENT PLUC	565	LEAD FRESH WATER	0	1305	No
PRODUCTION CASING	ABANDONMENT PLUC	50	LEAD FRESH WATER	25	90	No

<u>PERFORATIONS</u>	<u>Formation</u>	<u>Zone</u>	<u>Top</u>	<u>Btm</u>	<u>Date</u>	<u>Reason</u>	<u>Comments</u>
			3970	3971	04/11/2014	CEMENT SQUEEZE	
			5020	5021	04/11/2014	CEMENT SQUEEZE	
			6500	6501	04/09/2014	CEMENT SQUEEZE	
			6980	6981	04/09/2014	CEMENT SQUEEZE	
CODELL			7338	7356	06/17/1984	PRODUCTION	

KERR-MCGEE OIL AND GAS ONSHORE LP

WEBBER ELMER A 1
SW SW 10 3N 66W -- --

WELD,COLORADO

12/02/2014

AREA: N1

ROUTE: N12

Spud: 12/09/1977

WINS No.: 76892

AFE/WO#: 2095824

API#: 0512309345

GL: 4856

KB: 4866

MTD: 7983

TVD: 7983

LOG MD:

PBMD: 7846

PBTVD: 7846

Directions:

WCR 31 & WCR 34, E 2/10, N INTO

CODELL

7338

7348

12/29/1999

PRODUCTION

J SAND

7800

7848

05/02/1978

PRODUCTION

Comments: