

KERR-MCGEE OIL AND GAS ONSHORE LP
GORDON TURKEY FARMS B UNIT 1
SW SW 10 2N 67W 1,240' FSL 990' FWL
WELD,COLORADO
11/11/2014

AREA: WH

ROUTE: WH2 Spud: 08/17/1973

WINS No.: 74427

AFE/WO#: 2098370

API#: 0512307801

GL: 4975

KB: 4987

MTD: 8160


TVD: 8160

LOG MD: 8112

PBMD: 8104

PBTVD: 8104

Directions: WCR 22 & WCR 19, N 4/10, E 4/10 INTO

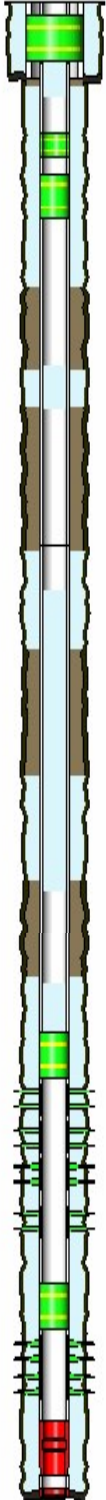

<u>HOLE SECTIONS</u>	<u>Size</u>	<u>Top</u>	<u>Btm</u>	<u>TD Date</u>
SURFACE	12.25	12	220	08/17/1973
PRODUCTION	7.88	220	8160	08/27/1973

<u>TUBULARS</u>	<u>Tool Type</u>	<u>Joints</u>	<u>Size</u>	<u>Weight</u>	<u>Grade</u>	<u>Thread</u>	<u>Top D</u>	<u>Bottom D</u>
SURFACE CASING	Casing	5	8.63	24.00	H-40	STC	12	219
PRODUCTION CASING	Casing	3	4.50	11.60	K-55	LT&C	12	111
	Casing	17	4.50	10.50	K-55	LT&C	111	654
	Cement Stage Too	1	4.50				654	657
	Casing	85	4.50	10.50	K-55	LT&C	657	3377
	Casing	145	4.50	11.60	K-55	LT&C	3377	8120
	Float Collar	1	4.50				8120	8122
	Casing	1	4.50	11.60	K-55	LT&C	8122	8155
	Casing Shoe	1	4.50				8155	8157
BRIDGE PLUG	Cast Iron Bridge Plu	1	4.50				7948	7949
BRIDGE PLUG	Cast Iron Bridge Plu	1	4.50				7230	7231
CAST IRON CEMENT RETAINER	Cement Retainer	1	4.50				785	786
BRIDGE PLUG	Cast Iron Bridge Plu	1	8.63				80	81

<u>CEMENT JOBS</u>	<u>Stage</u>	<u>Sacks</u>	<u>Cement Jobs</u>	<u>Top D</u>	<u>Btm D</u>	<u>cbl</u>
SURFACE CASING	STAGE 1	200	DJ - G	12	219	No
PRODUCTION CASING	STAGE 2	200	DJ - 50/50 POZMIX	284	657	Yes
	STAGE 1	200	DJ - 50/50 POZMIX	7420	8160	Yes
PRODUCTION CASING	SQUEEZE LEAD	50	DJ - G	3993	4043	Yes
	SQUEEZE TAIL	200	DJ - NEAT	4043	4190	Yes
PRODUCTION CASING	SQUEEZE LEAD	50	DJ 10-0 RFC	5200	5250	Yes
	SQUEEZE TAIL	200	DJ - G	5250	6020	Yes
PRODUCTION CASING	SQUEEZE JOB	100	LEAD CEMENT	1990	2284	Yes
PRODUCTION CASING	REMEDIAL CEMENT	200	LEAD CEMENT	6790	7420	Yes
PRODUCTION CASING	ABANDONMENT PLUC	25	LEAD CEMENT	6835	7230	No
	ABANDONMENT PLUC	160	TAIL CEMENT	4126	6108	No
PRODUCTION CASING	ABANDONMENT PLUC	30	LEAD CEMENT	3730	4126	No
	ABANDONMENT PLUC	30	TAIL CEMENT	1950	2300	No
PRODUCTION CASING	SQUEEZE JOB	430	LEAD CEMENT	730	1320	No
	SQUEEZE JOB	80	TAIL CEMENT	409	730	No
PRODUCTION CASING	ABANDONMENT PLUC	80	LEAD CEMENT	96	378	No

<u>PERFORATIONS</u>

KERR-MCGEE OIL AND GAS ONSHORE LP
GORDON TURKEY FARMS B UNIT 1
SW SW 10 2N 67W 1,240' FSL 990' FWL
WELD,COLORADO
11/11/2014

AREA: WH ROUTE: WH2 Spud: 08/17/1973 WINS No.: 74427 AFE/WO#: 2098370 API#: 0512307801

GL: 4975 KB: 4987 MTD: 8160 TVD: 8160 LOG MD: 8112 PBMD: 8104 PBTVD: 8104

Directions: WCR 22 & WCR 19, N 4/10, E 4/10 INTO

<u>Formation</u>	<u>Zone</u>	<u>Top</u>	<u>Btm</u>	<u>Date</u>	<u>Reason</u>	<u>Comments</u>
SUSSEX		730	731	10/13/2014	CEMENT SQUEEZE	
SUSSEX		1320	1321	10/13/2014	CEMENT SQUEEZE	
		4180	4181	08/03/1996	CEMENT SQUEEZE	
		6010	6011	08/02/1996	CEMENT SQUEEZE	
		6790	6791	06/04/2010	CEMENT SQUEEZE	
NIOBRARA		7278	7284	06/09/2010	PRODUCTION	
NIOBRARA		7350	7362	06/09/2010	PRODUCTION	
NIOBRARA		7408	7424	06/09/2010	PRODUCTION	
		7420	7421	06/04/2010	CEMENT SQUEEZE	
CODELL		7557	7576	08/06/1996	PRODUCTION	4 SPF
J SAND		7988	8004	04/02/1974	PRODUCTION	1 SPF
J SAND		8016	8036	04/02/1974	PRODUCTION	1 SPF

Comments: