


PROPOSED

C/NE/ Sec. 30-335-43W

API # 05-009-06581-00

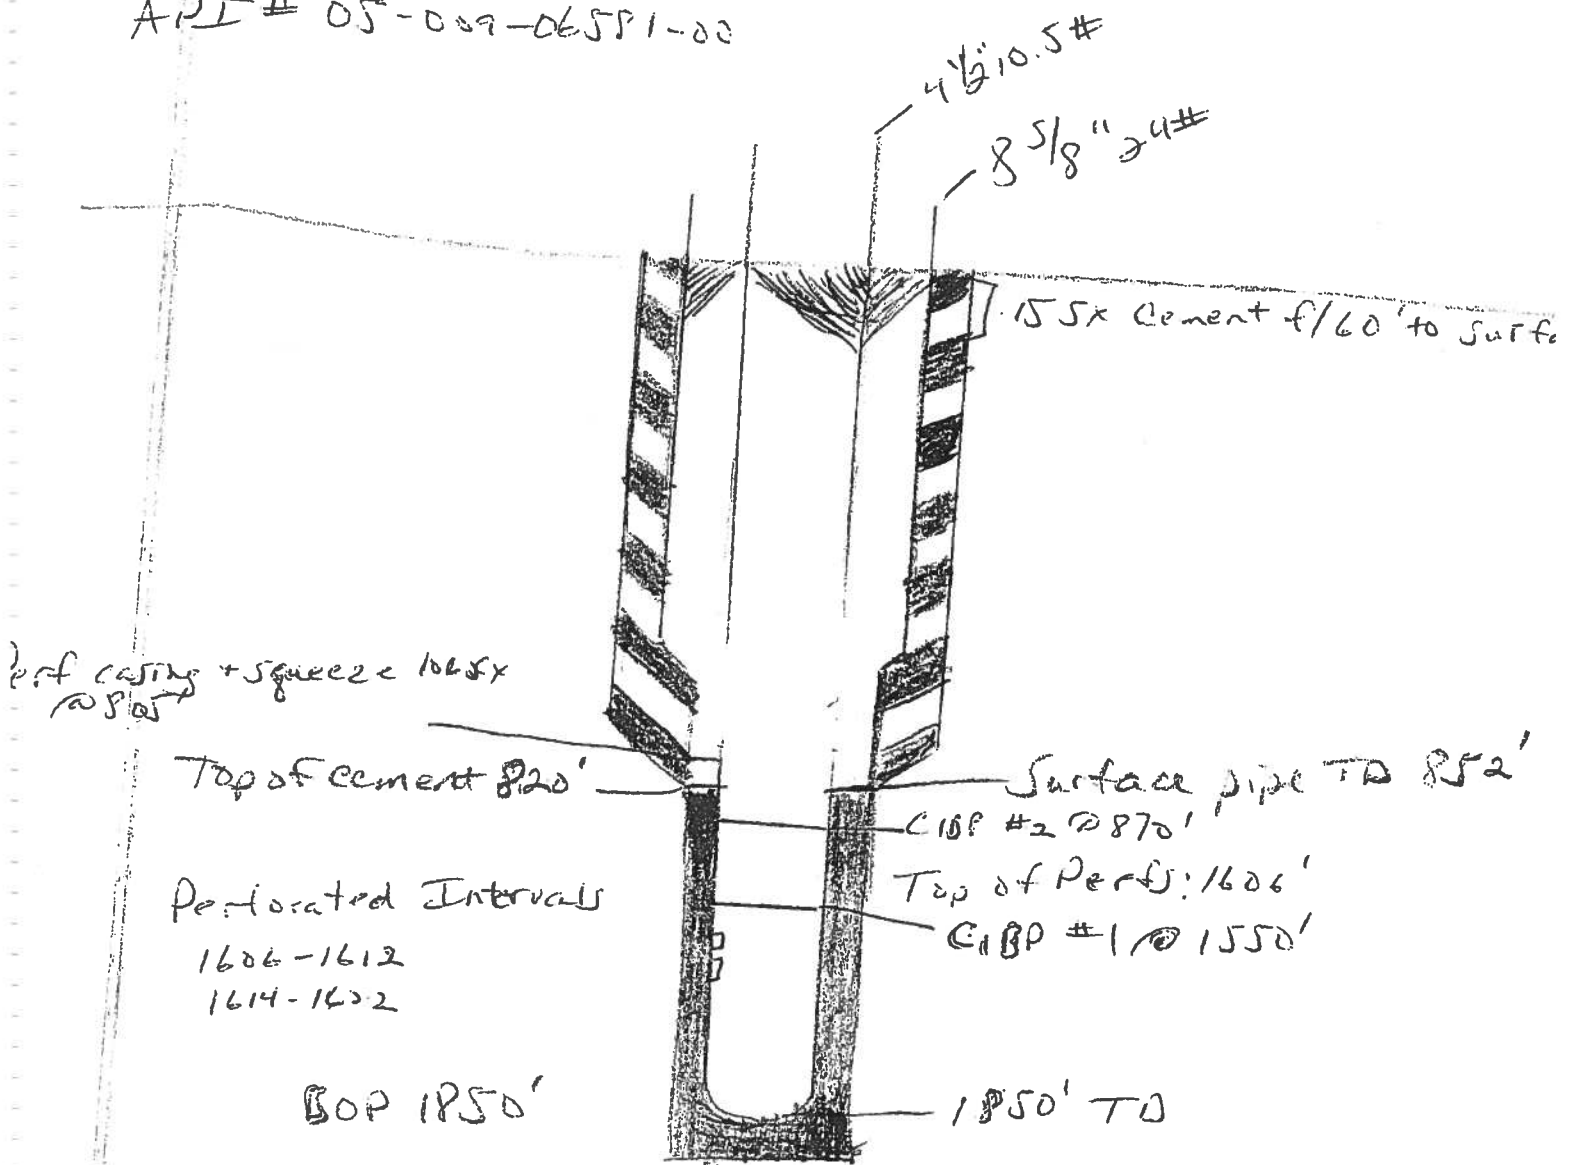


Grotto Rouge 1-3-
C/NE/ Sec. 30-335-43W
API # 05-029-06581-00



RECEIVED

DEC - 1 2014

COGCC

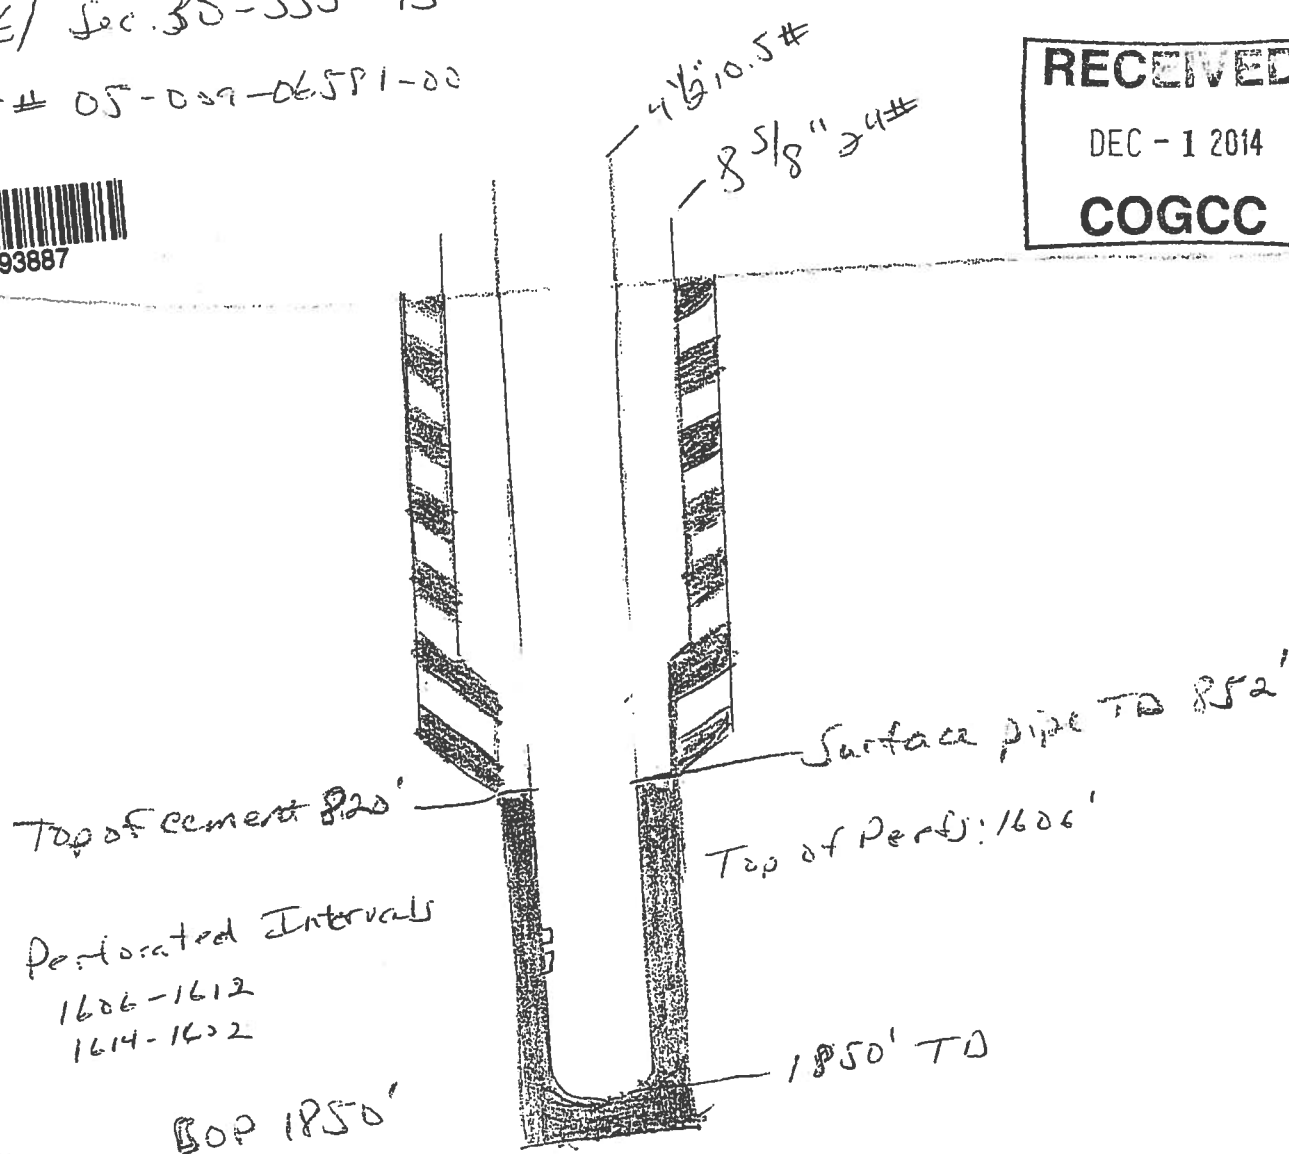

Current configuration