

WPX Energy Rocky Mountain LLC

FEDERAL NER 533-32


RULISON Field

SHL: 125' FNL 2585' FWL (SE/4 NW/4) LOT 2 Section 5 T7S R93W 6th PM

BHL: 1417' FSL 1709' FEL (NW/4 SE/4) Section 32 T6S R93W 6th PM

Garfield County Colorado

Formation Tops
(Measured Depths)

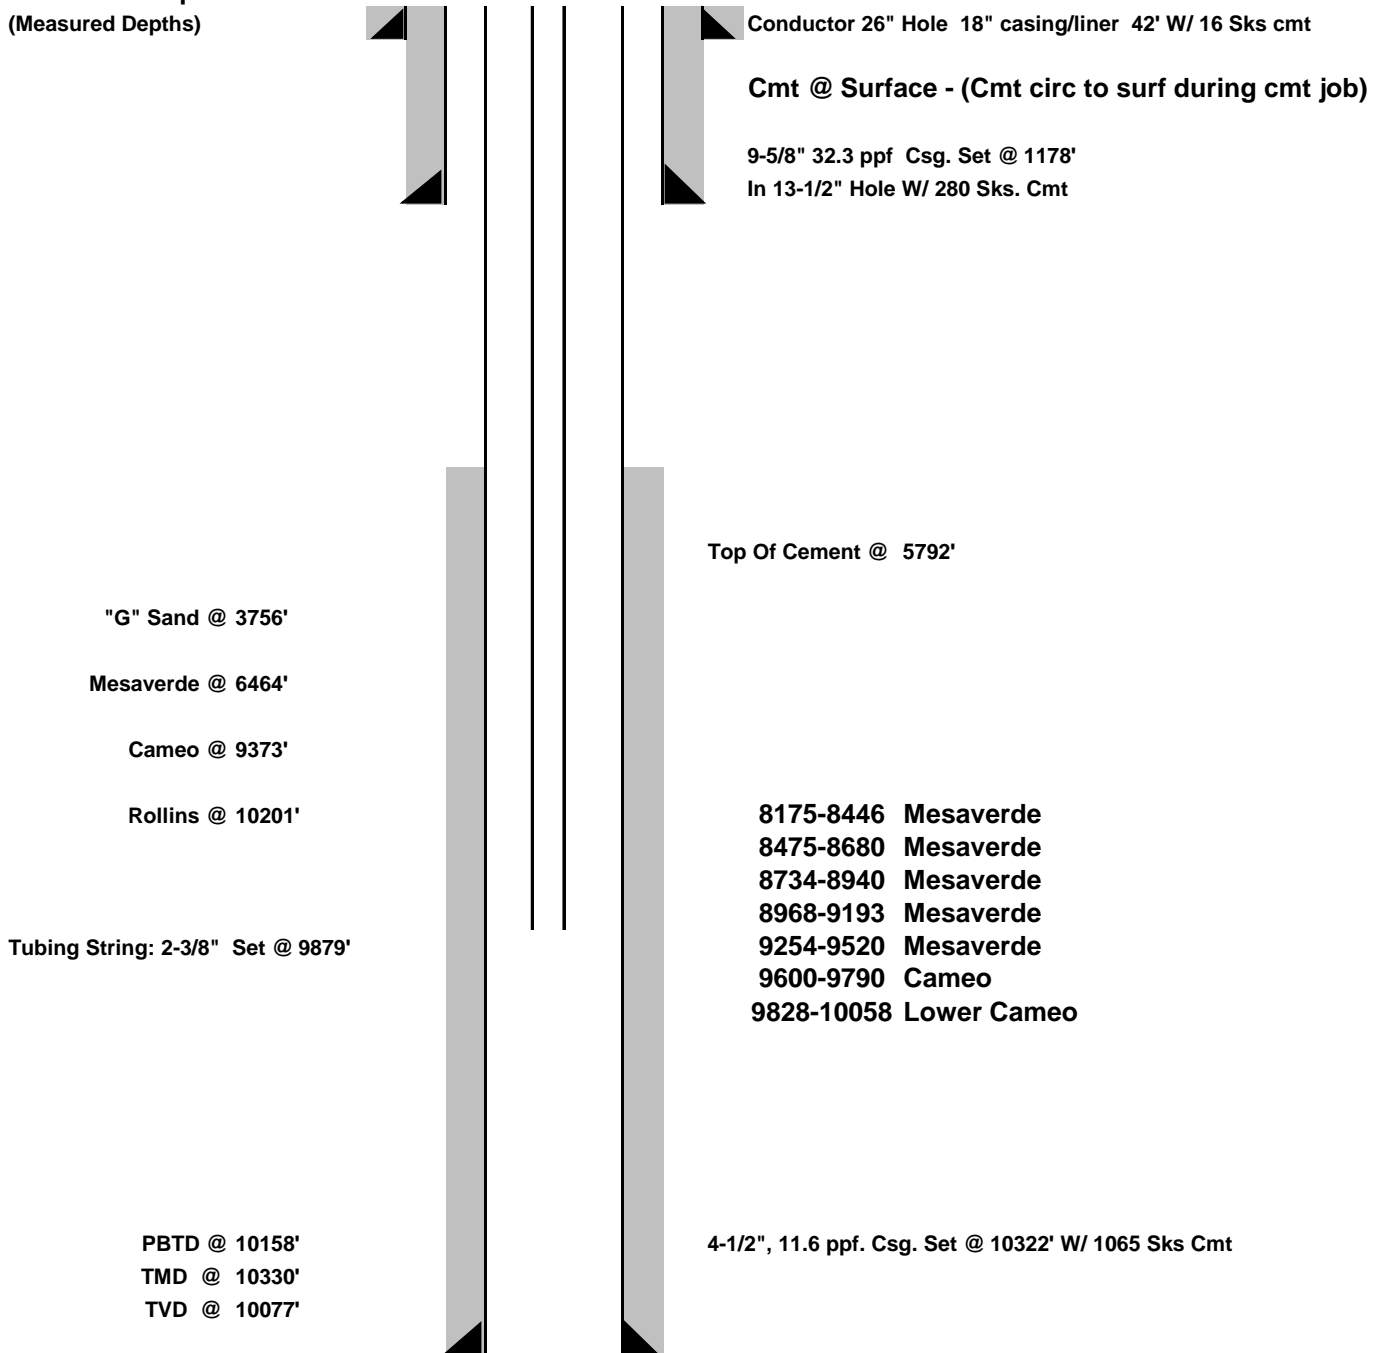

DATE CREATED: 12.3.2014

NOTE: THIS IS NOT TO SCALE.
****FINAL****