


**PRECISIONEERING, INC.**  
**WELLBORE DIAGRAM**

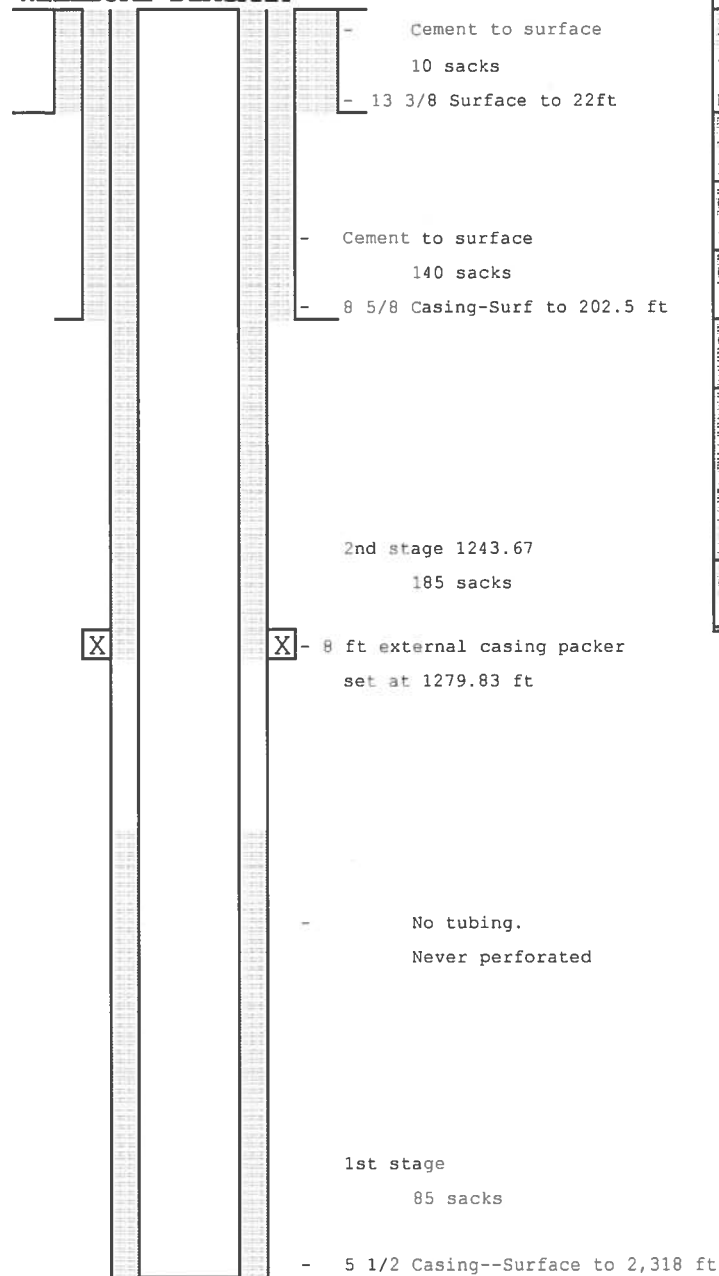

Lease & Well Number			
O'Neal 1-14A			
Location:			
715' FNL 743' FWL projected section-MaxwellLndGrnt			
NWNW Sec14, T33S, R68W			
Field		Comp Date	
Raton		WOPL	
County	State	TD	PBTD
Las Animas	CO	2356	2318
GL	KB		
8065	8073		
Completion Zone(s)			
Name	Perfs	IP	
Zone 1	none		
Zone 2	never perforated		
Zone 3			
Zone 4			
Zone 5			
Current Well Status:			
Waiting on pipeline			

Pgm ver.: 2.01  
Date: 08/31/93

Well Name and Number		
O'Neal 1-14A		
Date	Well History and Remarks	
	Raton Core #1 2072-2102	Rec 30 ft sandstone
	Raton Core #2 2166-2196	Rec 30 ft shale
	Raton Core #3 2196-2225	Rec 1 ft coal, 28 ft shale
	No TESTS	
	Raton 655 to 1287 ft	multiple 1-2 ft coal stringers
	Vermejo 1930 to 2257 ft	multiple 1-2 ft coal stringers
	Raton Surface (8065 ft)	ss, sh, coal
	Vermejo 1919 ft	ss, sh, coal
	Trinidad 2264 ft	ss