

**WPX Energy Rocky Mountain LLC**

**FEDERAL NER 424-32**


**RULISON Field**

**SHL: 117' FNL 2583' FWL (LOT 2 SE/4 NW/4) Section 5 T7S R93W 6th PM**

**BHL: 619' FSL 2224' FWL (SE/4 SEW4) Section 32 T6S R93W 6th PM**

**Garfield County Colorado**

**Formation Tops**  
(Measured Depths)

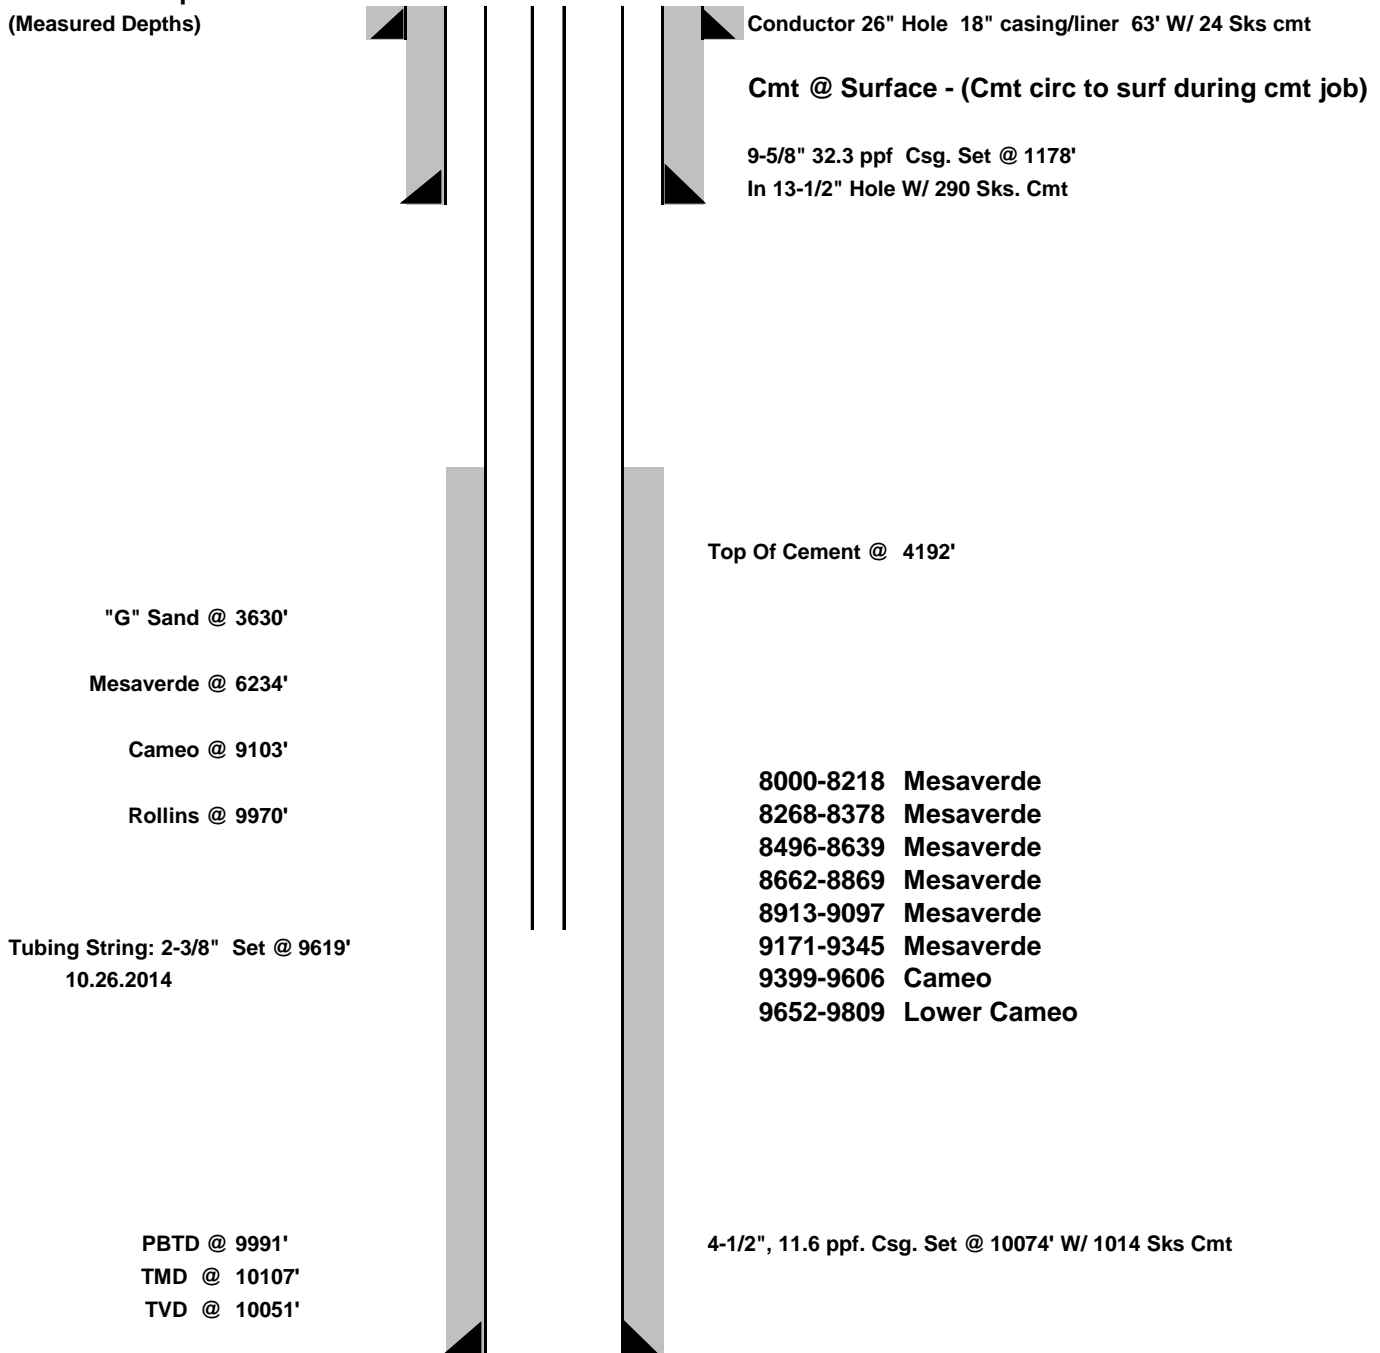

**DATE CREATED: 12.8.2014**

**NOTE: THIS IS NOT TO SCALE.**  
**\*\*FINAL\*\***