


Well Name: WAGNER 30-33

VERTICAL - ORIGINAL HOLE, 12/8/2014 2:51:00 PM

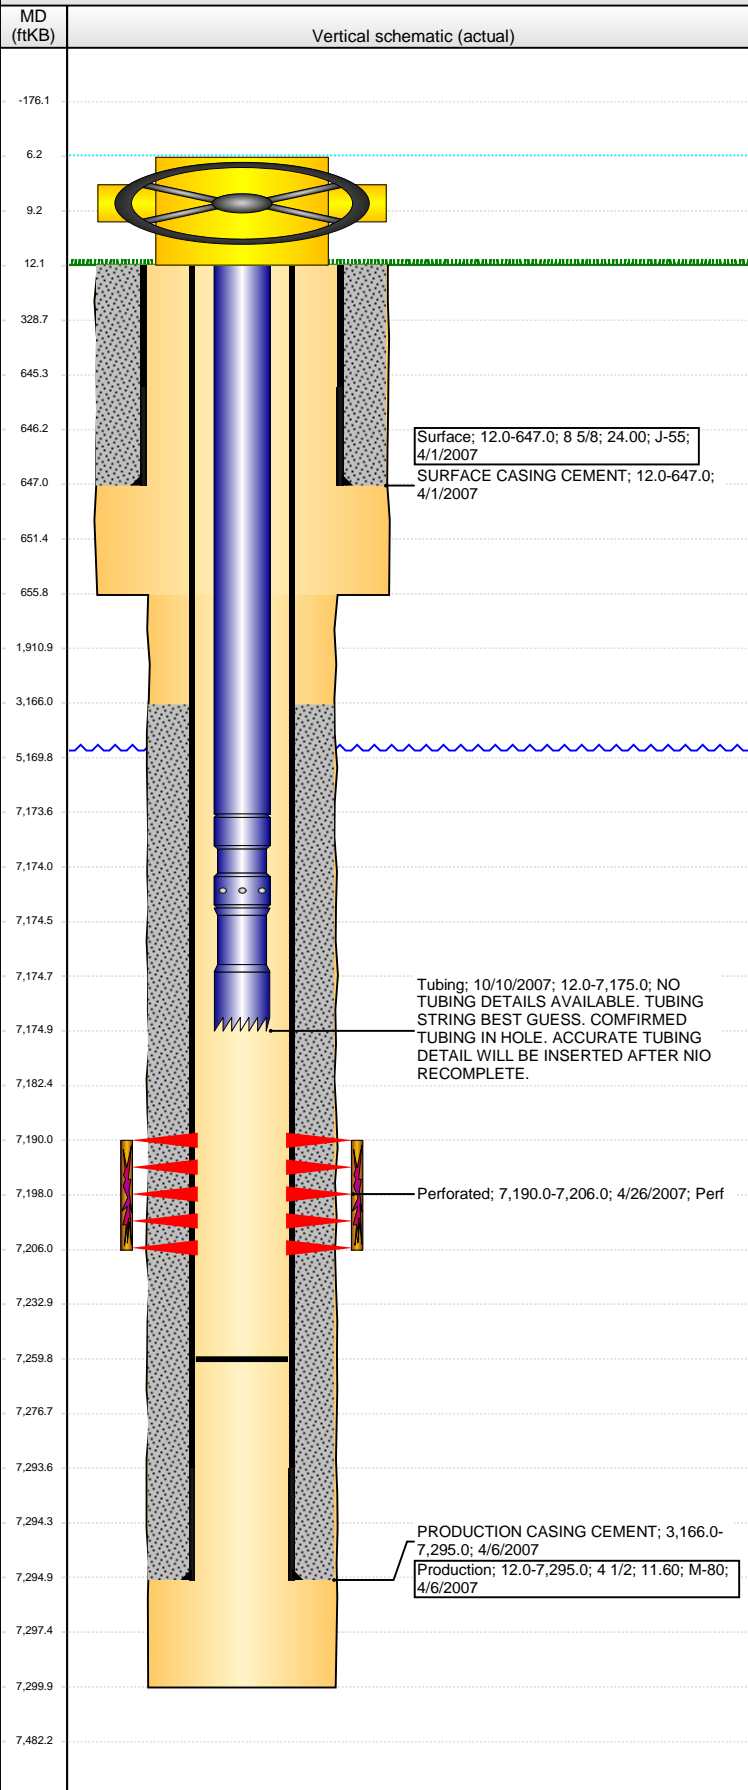

Well Header

API 05-123-24808	Business Unit DJ BASIN	District 15	Well Config VERTICAL
Original KB Elevation (ft) 4,860.00	KB - GL / MSL (ftKB) 12.00	Spud Date 3/31/2007	P & A Date

Comment

TUBING MOST LIKELY 2 3/8" 4.7# J-55, BUT NO DETAILS AVAILABLE

GYRO STACKED OUT IN TUBING @ 2320'

Directions To Well

Congressional Location

Quarter 1	Quarter 2	Quarter 3	Quarter 4	Section	Township	Twntshp N...	Range	Rng E/W Dir
		SW	SW	30	7	N	64	W

Bottom Hole Location

North-South Distance (ft)	From N or S Line	East-West Distance (ft)	From E or W Line

Plug Back Total Depths

Date	Depth (ftKB)	Method	Com
4/6/2007	7,293.0	CASING TALLY	TOP OF FLOAT COLLAR
4/26/2007	7,233.0	CASED HOLE LOG	CBL DEPTH LOGGER
10/18/2007	7,260.0	TAG	MOST RECENT C/O

Wellbore Sections

Section Des	Size (in)	Act Top, MD (ftKB)	Act Btm, MD (ftKB)
SURFACE	12 1/4	12.0	656.0
PRODUCTION	7 7/8	656.0	7,300.0

Zone Statuses

Zone Name	Status Date	Status	Job
CODELL	9/25/2007	PR	DRILLING/COMPLETION - ORIGINAL, 3/31/2007 00:00

Casing Strings

Surface, 647.0ftKB

Casing Description	Run Date	OD (in)	Wt/Len (l...)	Grade	Top, MD (ft...)	MD (ftKB)
Surface	4/1/2007	8 5/8	24.00	J-55	12.0	647.0

Production, 7,295.0ftKB

Casing Description	Run Date	OD (in)	Wt/Len (l...)	Grade	Top, MD (ft...)	MD (ftKB)
Production	4/6/2007	4 1/2	11.60	M-80	12.0	7,295.0

Cement

Description	Top Depth (ftKB)	Bottom Depth (ftKB)
SURFACE CASING CEMENT	12.0	647.0
PRODUCTION CASING CEMENT	3,166.0	7,295.0

Tubing Components

Item Des	OD (in)	Wt (lb/ft)	Grade	Jts	Len (ft)	Btm (ftKB)	Btm (TVD) (ftKB)
Tubing	2 3/8	4.70	J-55	224	7,161.40	7,173.4	
Seal Nipple	2 3/8			1	1.00	7,174.4	
Notched collar	2 3/8			1	0.60	7,175.0	

Perforation Data

Zone	Bnch/St g	Entered Shot Total	Top (ftKB)	Btm (ftKB)	Date
CODELL, ORIGINAL HOLE		64	7,190.00	7,206.00	4/26/2007

Stimulations & Treatments

Date	Zone	Primary Job Type
4/27/2007	CODELL, ORIGINAL HOLE	DRILLING/COMPLETION - ORIGINAL
Technical Result	Tech Result Details	Tech Result Note

Comment

Other In Hole

Run Date	Des	OD (in)	Top (ftKB)	Btm (ftKB)

Logs

Date	Type	Top, MD (ftKB)	Btm, MD (ftKB)
4/5/2007	COMPENSATED DENSITY	3,000.0	7,277.0
4/5/2007	INDUCTION	647.0	7,297.0
4/26/2007	CBL/CCL/GR	3,050.0	7,231.0
2/10/2014	GYRO	10.0	2,322.0