



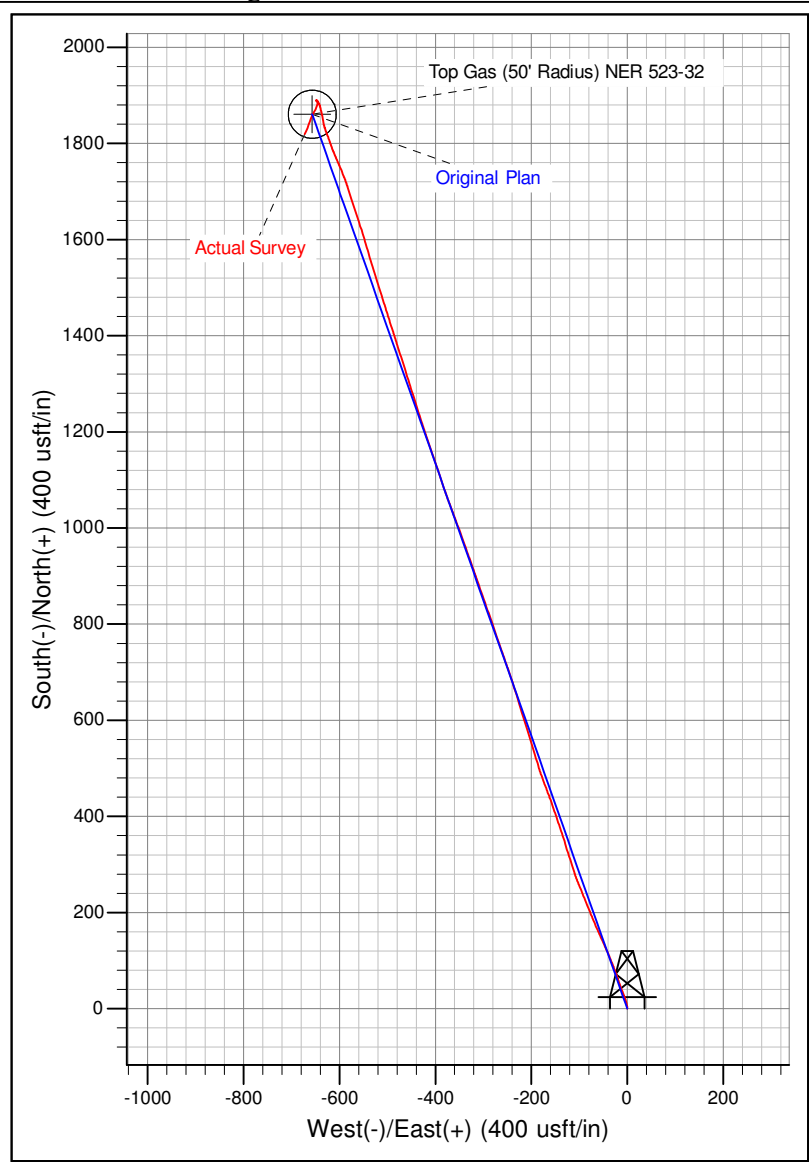

Well Name: NER 523-32
Surface Location: Single Cellar RU 23-5 Pad
North American Datum 1983 , US State Plane 1983 , Colorado Central Zone
Ground Elevation: 7602.00
+N/-S +E/-W Northing Easting Latitude Longitude Slot
0.00 0.00 1606125.60 2351120.40 39.47505 -107.79892 A1
KELLY BUSHING @ 7628.00usft

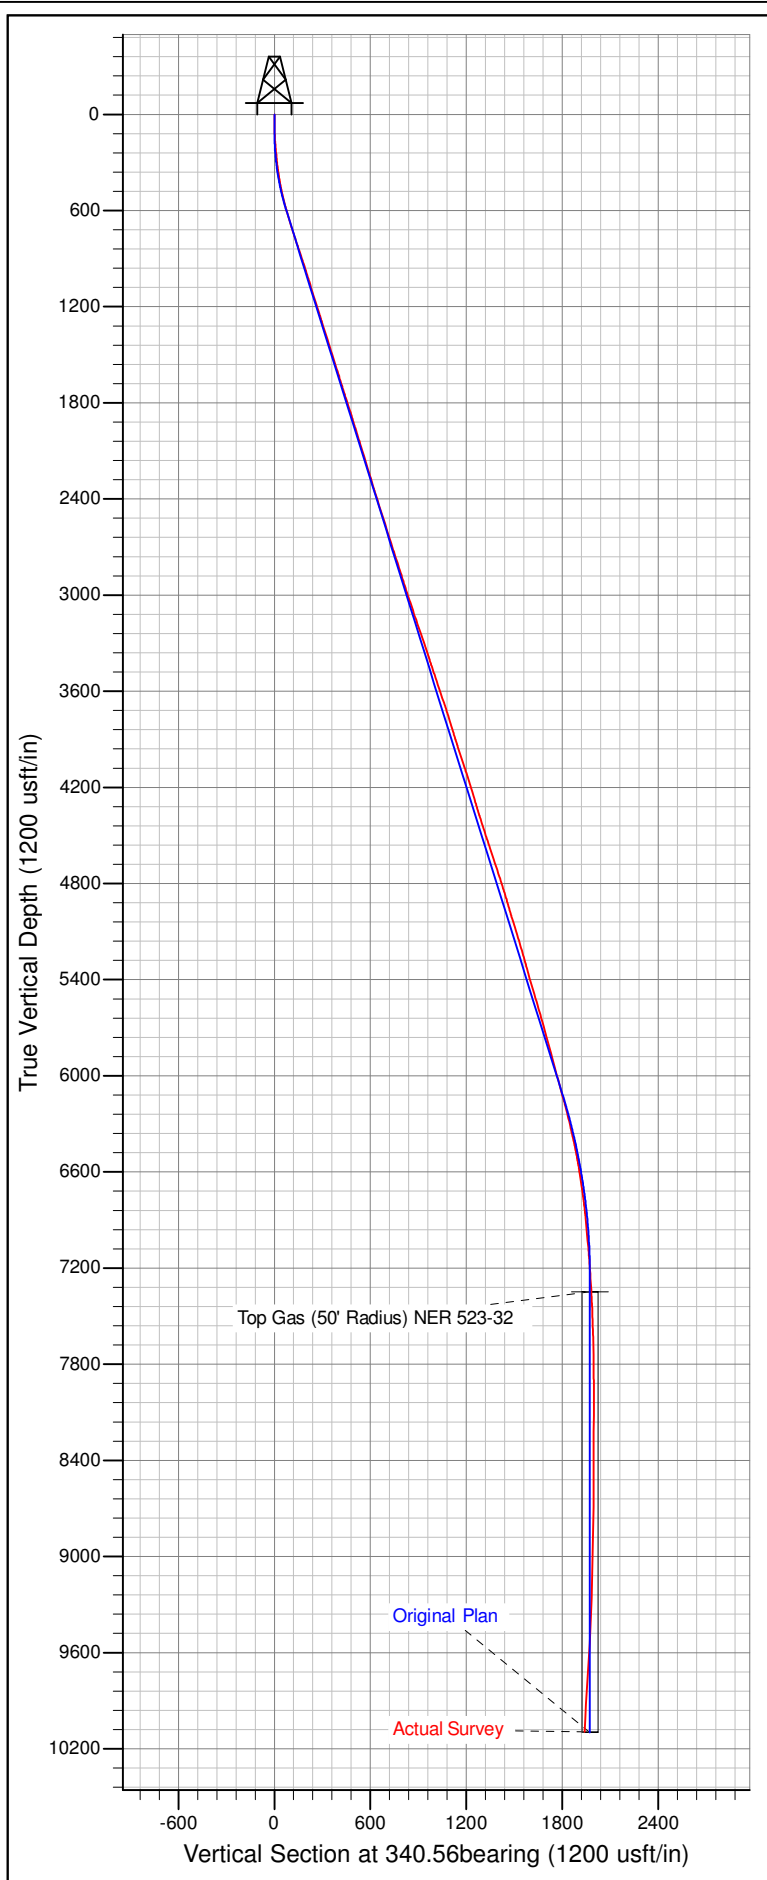

Azimuths to True North
Magnetic North: 9.84°

Magnetic Field
Strength: 51925.7snT
Dip Angle: 65.67°
Date: 9/4/2014
Model: IGRF2010