


**WPX Energy Rocky Mountain LLC
FEDERAL NER 523-32
RULISON Field**

**SHL: 113' FNL 2571' FWL (LOT 2 SE/4 NW/4) Section 5 T7S R93W 6th PM
BHL: 1706' FSL 1899' FWL (NE/4 SW/4) Section 32 T6S R93W 6th PM
Garfield County Colorado**

**Formation Tops
(Measured Depths)**

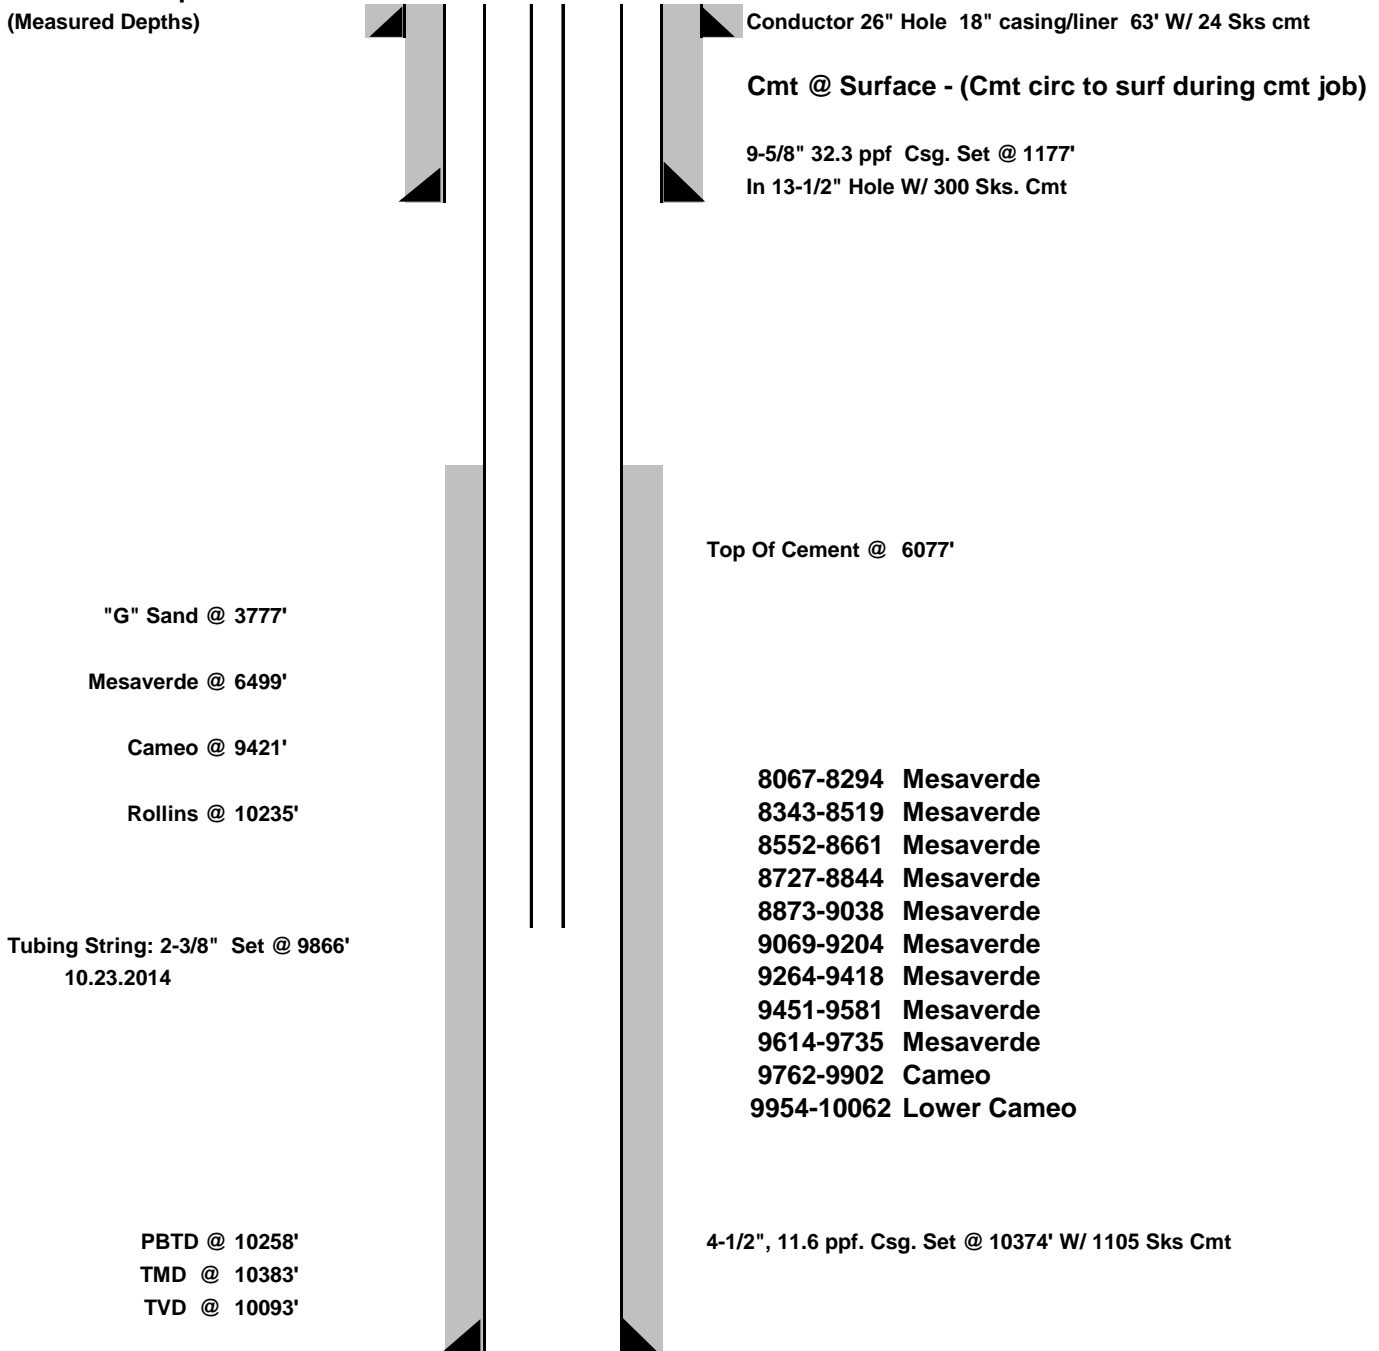

DATE CREATED: 12.9.2014

NOTE: THIS IS NOT TO SCALE.
****FINAL****