


After Replug Schematic:

10-3/4" 32.75# H40 Surface
Set @ 381' MD

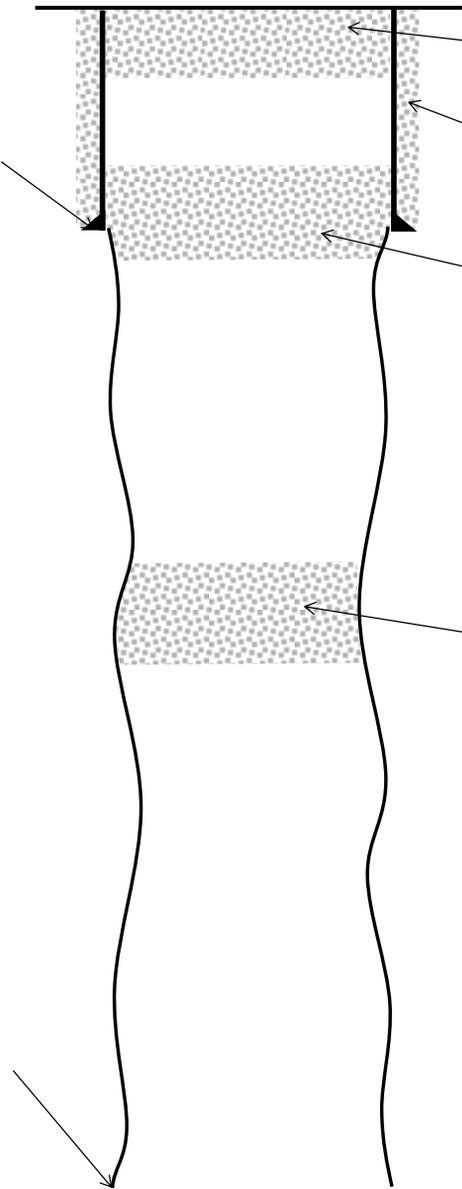

~95' cement @ top of surface csg

50 sx cement backside of surface casing

230 sx balanced plug from 224' to 441'

37 sx balanced plug from 2366' to 2503'

8 3/4" OH
To 9393' MD