


Well Name:		Linneburg Flying Service 3-61 #1-30			
Surface Location:	2417' FNL & 2362' FEL of Sec. 30, T3S, R61W	Prospect:	Perdido	County:	Adams
	Lat: 39.76128 Long: -104.25509	Field:	N/A	State:	Colorado
BH Location:	Same As SHL	API #:	0500109804	Spud Date	6/12/14

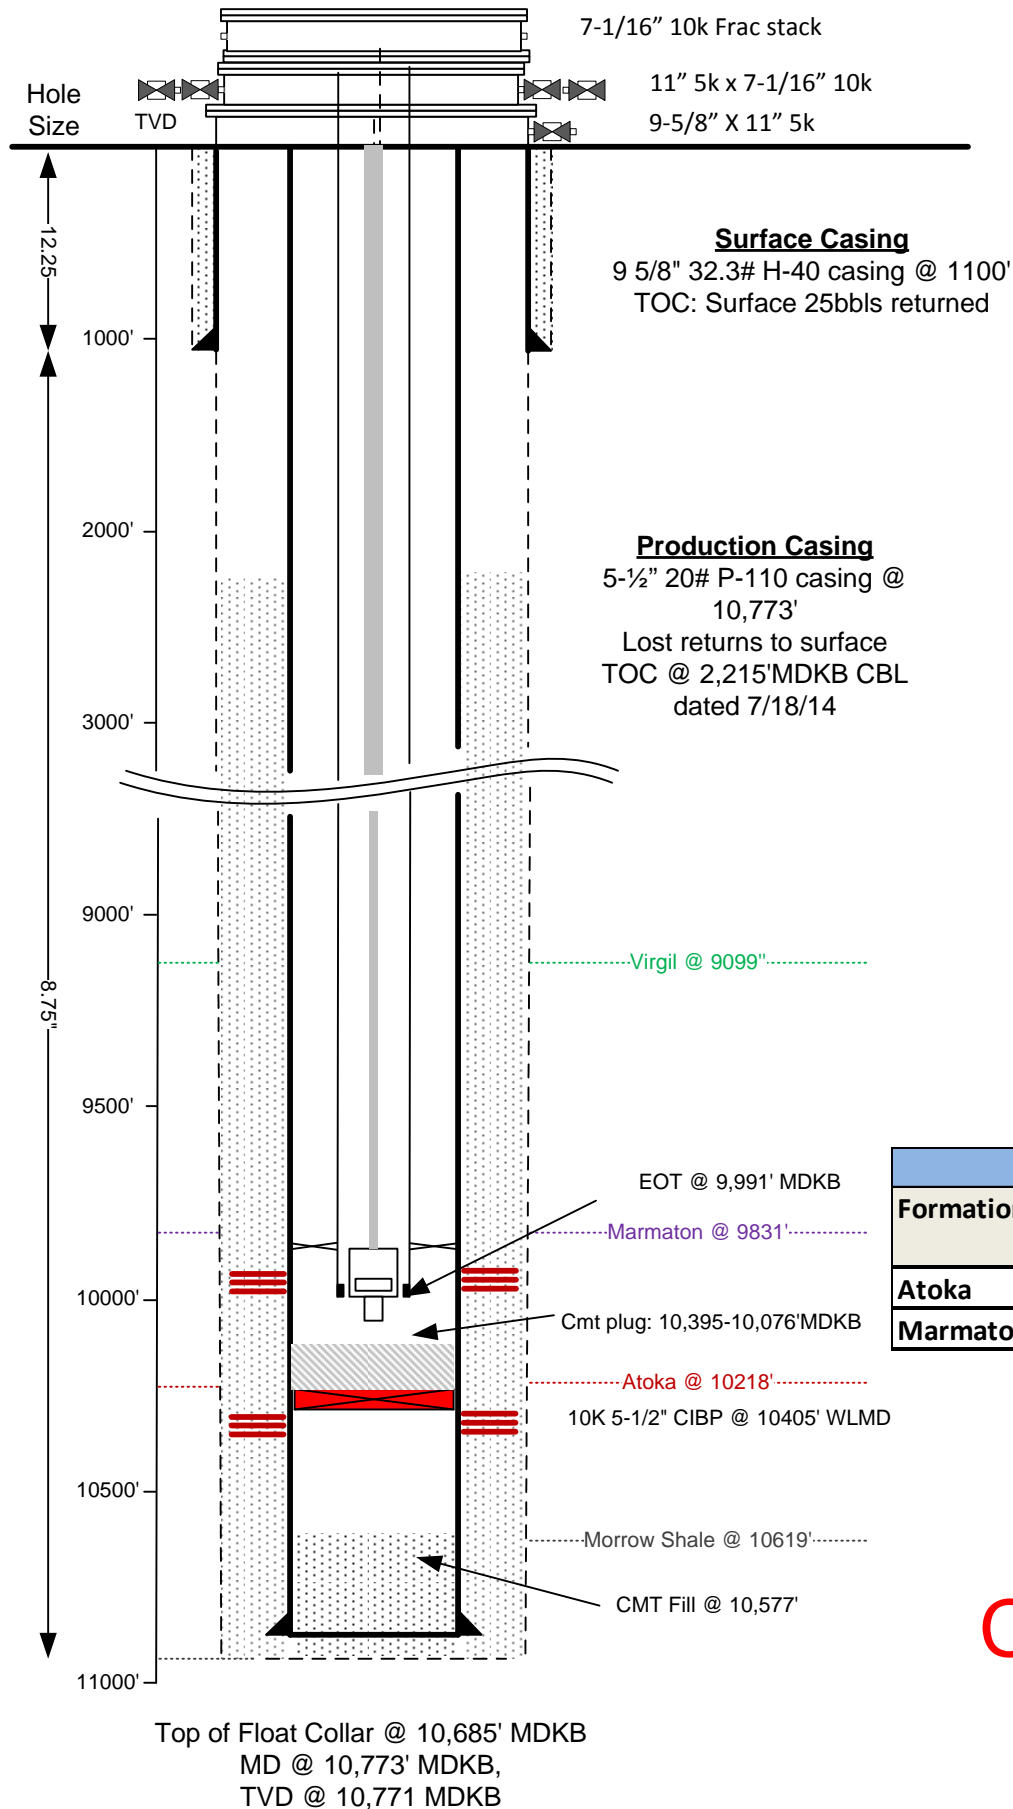

**Current**

Date Created:	December 14, 2014
Created By:	Ross Martin