

KERR-MCGEE OIL AND GAS ONSHORE LP

**COUTURE 1
CN W 11 4N 68W -- --
WELD,COLORADO
11/25/2014**

AREA: W2

ROUTE: W21 Spud: 11/11/1982

WINS No.: 87782

AFE/WO#: 2098826

API#: 0512310867

GL: 5000

KB: 5012

MTD: 7737


TVD: 7737

LOG MD:

PBMD: 7680

PBTVD:

Directions: I25 FRONTAGE RD & HWY 60, S 2/10, E 1/10 INTO

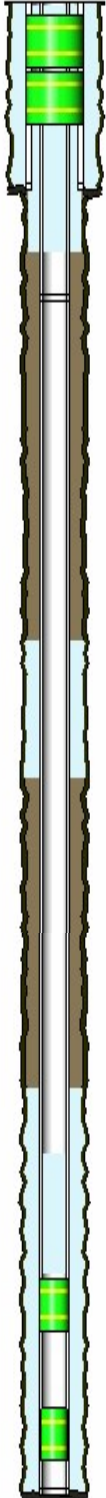

<u>HOLE SECTIONS</u>	<u>Size</u>	<u>Top</u>	<u>Btm</u>	<u>TD Date</u>
SURFACE	12.25	12	513	11/11/1982
PRODUCTION	7.88	513	7737	11/20/1982

<u>TUBULARS</u>	<u>Tool Type</u>	<u>Joints</u>	<u>Size</u>	<u>Weight</u>	<u>Grade</u>	<u>Thread</u>	<u>Top D</u>	<u>Bottom D</u>
SURFACE CASING	Casing	13	8.62	24.00	J-55		12	511
	Casing	1	8.62				511	512
PRODUCTION CASING	Casing	30	4.50	11.60	K-55		12	1180
	Casing	1	4.50				1180	1182
	Casing	162	4.50	11.60	K-55		1182	7729
	Casing	1	4.50				7729	7730
BRIDGE PLUG	Cast Iron Bridge Plu	1	3.99				7550	7552
BRIDGE PLUG	Cast Iron Bridge Plu		4.50				7080	7082
BRIDGE PLUG	CIBP With CMT Cap		8.63				70	74
BRIDGE PLUG	Cast Iron Bridge Plu		8.63				100	104

<u>CEMENT JOBS</u>	<u>Stage</u>	<u>Sacks</u>	<u>Cement Jobs</u>		<u>Top D</u>	<u>Btm D</u>	<u>cbl</u>
SURFACE CASING	PRIM CMT 1ST STAGE	325	Lead	CEMENT	12	512	No
PRODUCTION CASING	PRIM CMT 1ST STAGE	400	Lead	CEMENT	5934	7730	Yes
PRODUCTION CASING	Dump Bail	2	LEAD	CEMENT	7548	7550	No
PRODUCTION CASING	ABANDONMENT PLUC	55	LEAD	FRESH WATER	6330	7055	No
PRODUCTION CASING	SQUEEZE JOB				3230	4063	No
SURFACE CASING	TOP OUT JOB	260	TOP OUT	CACL2 WATER	295	880	No
SURFACE CASING	ABANDONMENT PLUC	50	LEAD	CEMENT	20	70	No

<u>PERFORATIONS</u>	<u>Formation</u>	<u>Zone</u>	<u>Top</u>	<u>Btm</u>	<u>Date</u>	<u>Reason</u>	<u>Comments</u>
	CODELL		7146	7160	11/22/1994	PRODUCTION	-- [WV Data Migration]
	CODELL		7147	7168	05/14/2004	PRODUCTION	-- [WV Data Migration]
	J SAND		7610	7630	12/31/1983	PRODUCTION	-- [WV Data Migration]

Comments: