





Lat40°, Inc. 1635 Foxtrail Drive, Suite 325 Loveland, CO 970-776-3321

PLUGGED & ABANDONED WELL EXHIBIT

SECTION: 21
TOWNSHIP: 5N
RANGE: 61W

THIS MAP DOES NOT REPRESENT A BOUNDARY SURVEY

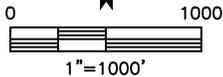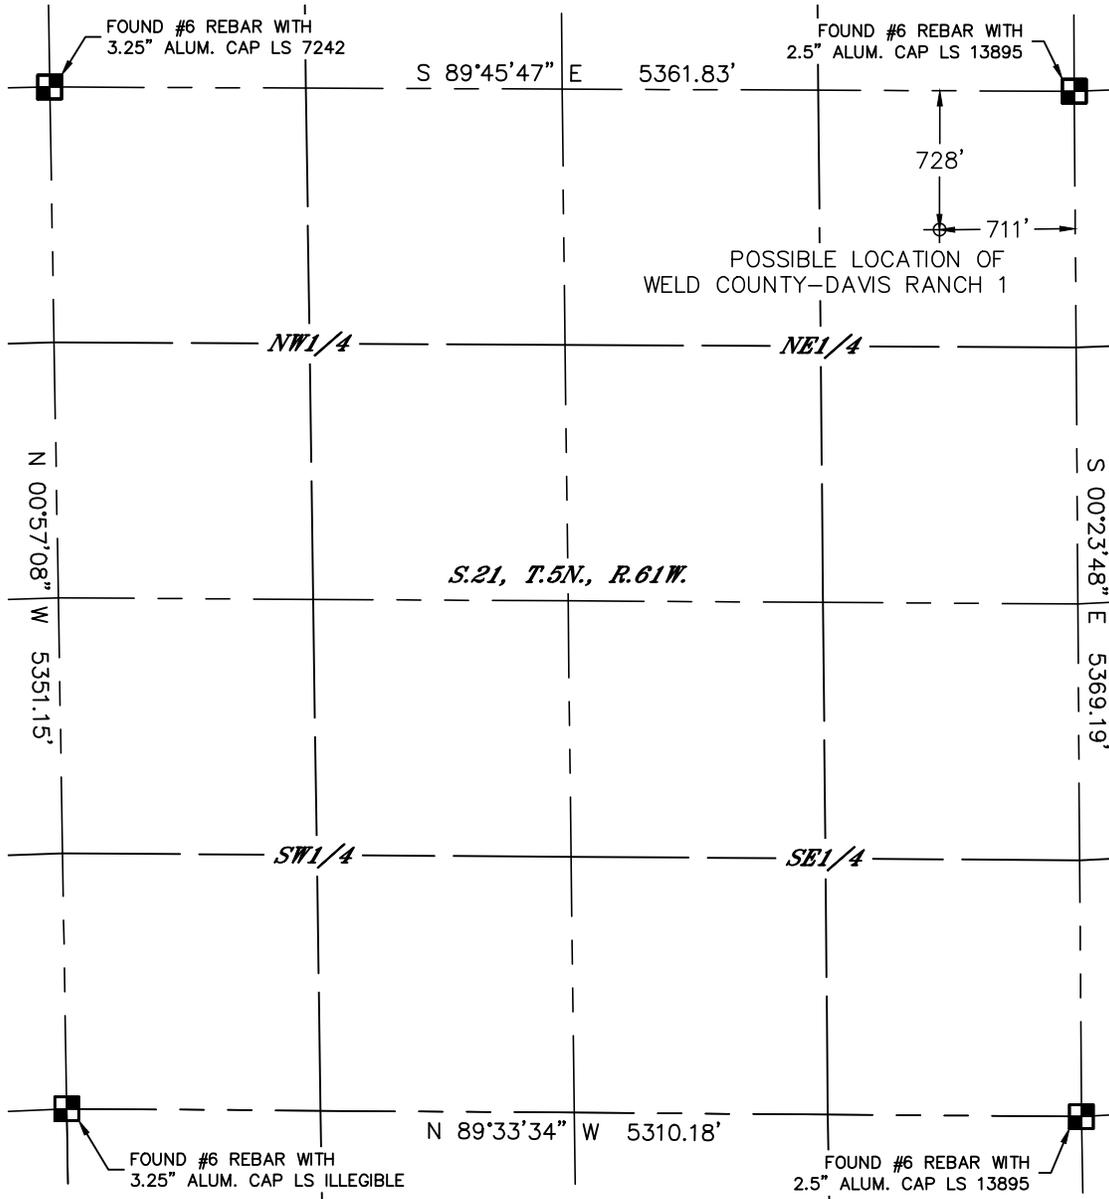

SURFACE LOCATION
 LAT: 40.39162°N
 LONG: 104.20701°W
 PDOP: 2.1
 ELEV: 4655'
 1/4,1/4: NE1/4NE1/4

SURFACE DESCRIPTION
 FOUND A STRONG METAL DETECTOR SIGNAL WITHIN 4' DIA. OF LOCATION. NO OTHER SIGNAL IN AREA. SET PINK LATH WITH FLAGGING.

LEGEND

- = ALIQUOT MONUMENT AS DESCRIBED
- = CALCULATED POSITION

DATE: 2/28/2014
PROJECT#: 2013173



Lat40°, Inc. 1635 Foxtrail Drive, Suite 325 Loveland, CO 970-776-3321

P&A WELL LOCATION PICTURES

WELD COUNTY-DAVIS RANCH 1

SECTION: 21
TOWNSHIP: 5N
RANGE: 61W

DATE: 1/23/2014



VIEW NORTH



VIEW WEST



VIEW EAST



VIEW SOUTH

DATE: 2/28/2014
PROJECT#: 2013173