

KERR-MCGEE OIL AND GAS ONSHORE LP

RADEMACHER 14-30

SE SW 30 3N 67W -- --

WELD,COLORADO

12/17/2014

AREA: W2

ROUTE: W24 Spud: 01/18/1995

WINS No.: 74633

AFE/WO#: 2104101

API#: 0512318848

GL: 4848

KB: 4858

MTD: 7416


TVD: 7416

LOG MD: 7415

PBMD: 7372

PBTVD: 7372

Directions: CR 28 & CR 13 N 100', E 5/10, S 2/10, W 1/10, N INTO

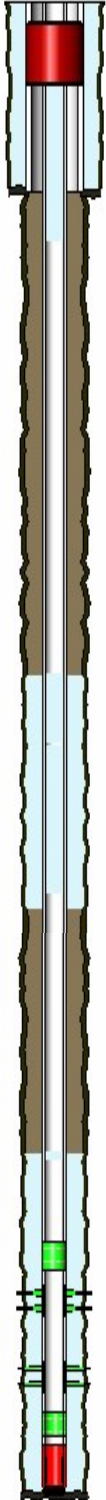

<u>HOLE SECTIONS</u>	<u>Size</u>	<u>Top</u>	<u>Btm</u>	<u>TD Date</u>
SURFACE	12.25	10	734	01/18/1995
PRODUCTION	7.88	734	7416	01/22/1995

<u>TUBULARS</u>	<u>Tool Type</u>	<u>Joints</u>	<u>Size</u>	<u>Weight</u>	<u>Grade</u>	<u>Thread</u>	<u>Top D</u>	<u>Bottom D</u>
SURFACE CASING	Casing	17	8.63	23	J-55	STC	10	729
PRODUCTION CASING	Casing	182	3.50	7.7	KS-70/80	10 RD IJ	10	7371
		1	3.50				7371	7372
	Casing	1	3.50	7.7	KS-70/80	10 RD IJ	7372	7410
	Casing Guide Shoe	1	3.50				7410	7411
BRIDGE PLUG	Cast Iron Bridge Plu	1	3.50				6970	6971
BRIDGE PLUG	Wellbore Equipment	1	8.63				100	102

<u>CEMENT JOBS</u>	<u>Stage</u>	<u>Sacks</u>	<u>Cement Jobs</u>	<u>Top D</u>	<u>Btm D</u>	<u>cbl</u>
SURFACE CASING	STAGE 1	510	NEAT	10	729	No
PRODUCTION CASING	STAGE 2	395	PREMIUM	3603	4994	Yes
	STAGE 1	165	PREMIUM	6448	7411	Yes
PRODUCTION CASING	ABANDONMENT PLUG			4022	4900	No
PRODUCTION CASING	ABANDONMENT PLUG			6432	4965	No
PRODUCTION CASING	ABANDONMENT PLUG			3590	4012	No
PRODUCTION CASING	ABANDONMENT PLUG			330	1025	No

<u>PERFORATIONS</u>	<u>Formation</u>	<u>Zone</u>	<u>Top</u>	<u>Btm</u>	<u>Date</u>	<u>Reason</u>	<u>Comments</u>
	NIOBRARA		7049	7050	02/03/1995	PRODUCTION	
	CODELL		7265	7275	01/08/2003	PRODUCTION	
	CODELL		7269	7274	02/03/1995	PRODUCTION	

Comments: