


Well Name: WAGNER 30-35

VERTICAL - ORIGINAL HOLE, 12/17/2014 10:45:43 AM

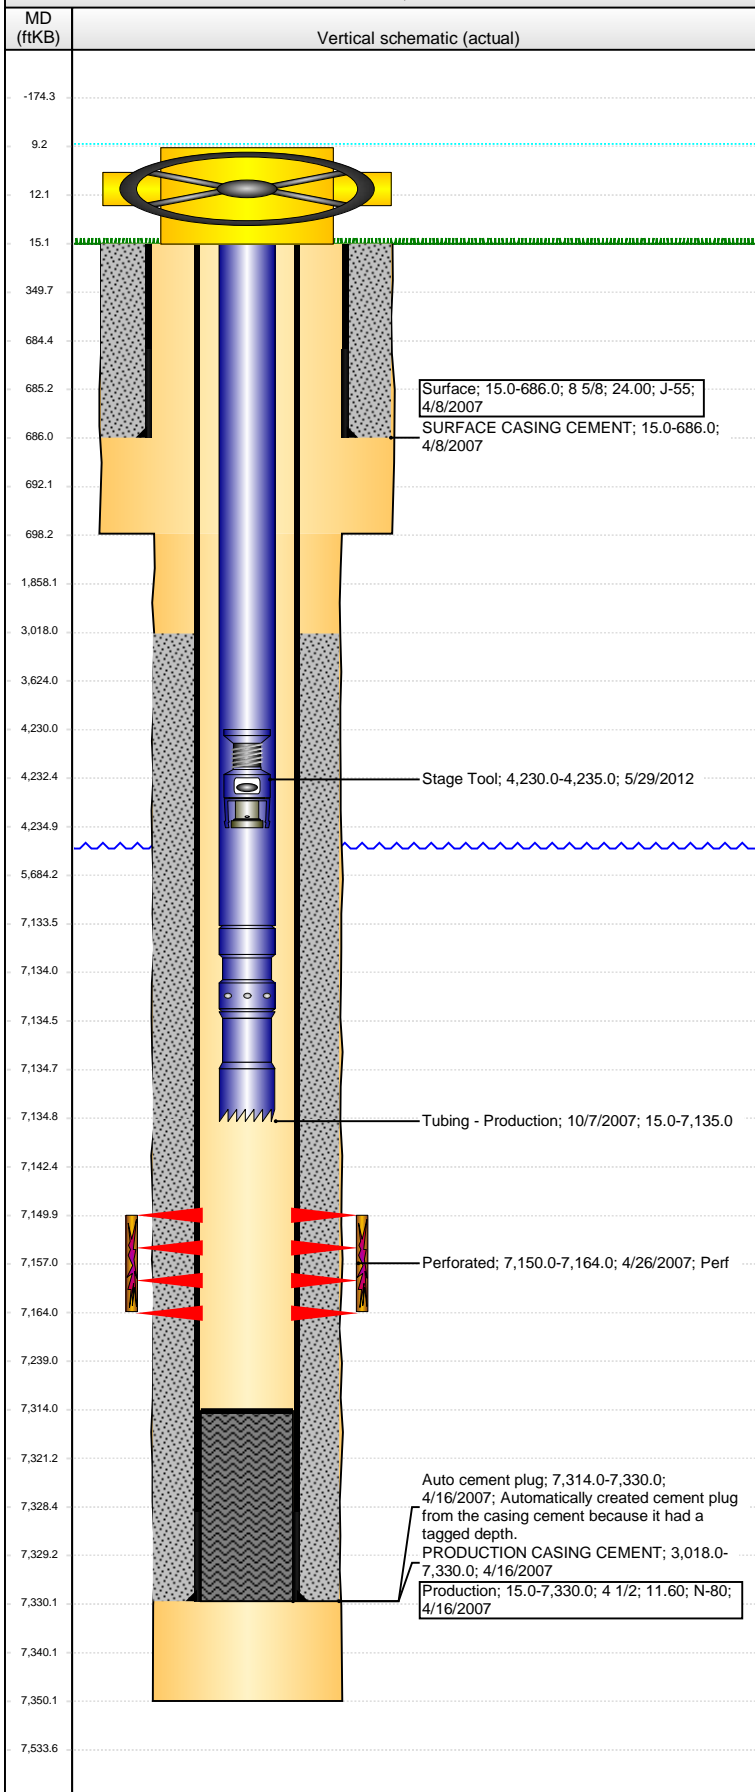

Well Header

API	Business Unit	District	Well Config
05-123-24917	DJ BASIN	15	VERTICAL
Original KB Elevation (ft)	KB - GL / MSL (ftKB)	Spud Date	P & A Date
4,873.00	15.00	4/7/2007	

Comment

TUBING MOST LIKELY 2 3/8" 4.7# J-55, BUT DETAILS UNKNOWN

Directions To Well

Congressional Location

Quarter 1	Quarter 2	Quarter 3	Quarter 4	Section	Township	Twnshp N...	Range	Rng E/W Dir
		NW	SW	30	7	N	64	W

Bottom Hole Location

North-South Distance (ft)	From N or S Line	East-West Distance (ft)	From E or W Line

Plug Back Total Depths

Date	Depth (ftKB)	Method	Com
4/16/2007	7,314.0	CASING TALLY	TOP OF FLOAT COLLAR
4/26/2007	7,305.0	CASED HOLE LOG	CBL DEPTH LOGGER
10/12/2007	7,314.0	TAG	C/O TO PBTD

Wellbore Sections

Section Des	Size (in)	Act Top, MD (ftKB)	Act Btm, MD (ftKB)
SURFACE	12 1/4	15.0	698.0
PRODUCTION	7 7/8	698.0	7,350.0

Zone Statuses

Zone Name	Status Date	Status	Job
CODELL	9/12/2007	PR	DRILLING/COMPLETION - ORIGINAL, 4/7/2007 00:00

Casing Strings

Surface, 686.0ftKB

Casing Description	Run Date	OD (in)	Wt/Len (l...)	Grade	Top, MD (ft...)	MD (ftKB)
Surface	4/8/2007	8 5/8	24.00	J-55	15.0	686.0

Production, 7,330.0ftKB

Casing Description	Run Date	OD (in)	Wt/Len (l...)	Grade	Top, MD (ft...)	MD (ftKB)
Production	4/16/2007	4 1/2	11.60	N-80	15.0	7,330.0

Cement

Description	Top Depth (ftKB)	Bottom Depth (ftKB)
SURFACE CASING CEMENT	15.0	686.0
PRODUCTION CASING CEMENT	3,018.0	7,330.0

Tubing Components

Item Des	OD (in)	Wt (lb/ft)	Grade	Jts	Len (ft)	Btm (ftKB)	Btm (TVD) (ftKB)
Tubing	2 3/8	4.70	J-55	222	7,118.40	7,133.4	
Seal Nipple	2 3/8			1	1.00	7,134.4	
Notched collar	2 3/8			1	0.60	7,135.0	

Perforation Data

Zone	Bnch/St g	Entered Shot Total	Top (ftKB)	Btm (ftKB)	Date
CODELL, ORIGINAL HOLE		56	7,150.00	7,164.00	4/26/2007

Stimulations & Treatments

Date	Zone	Primary Job Type
4/30/2007	CODELL, ORIGINAL HOLE	DRILLING/COMPLETION - ORIGINAL
Technical Result		Tech Result Details
		Tech Result Note
Comment		

Other In Hole

Run Date	Des	OD (in)	Top (ftKB)	Btm (ftKB)
5/29/2012	Stage Tool	2	4,230.0	4,235.0

Logs

Date	Type	Top, MD (ftKB)	Btm, MD (ftKB)
4/13/2007	COMPENSATED DENSITY	686.0	7,345.0
4/13/2007	INDUCTION	686.0	7,345.0
4/26/2007	CBL/CCL/GR	2,900.0	7,303.0