


Well Name: WILHITE 30-31

VERTICAL - ORIGINAL HOLE. 12/17/2014 11:18:11 AM

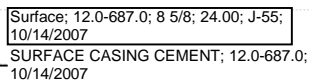

Well Header							
API 05-123-24806		Business Unit DJ BASIN		District 15		Well Config VERTICAL	
Original KB Elevation (ft) 4,873.00		KB - GL / MSL (ftKB) 12.00		Spud Date 10/13/2007		P & A Date	
Comment							
Directions To Well							
Congressional Location							
Quarter 1	Quarter 2	Quarter 3 NE	Quarter 4 SW	Section 30	Township 7 N	Twnshp N... Range 64	Rng E/W Dir W
Bottom Hole Location							
North-South Distance (ft)		From N or S Line		East-West Distance (ft)		From E or W Line	
Plug Back Total Depths							
Date	Depth (ftKB)	Method			Com		
10/18/2007	7,268.0	CASING TALLY			TOP OF FLOAT COLLAR		
11/27/2007	7,245.0	TAG			CBL DEPTH LOGGER		
1/5/2008	7,274.0	TAG			MOST RECENT C/O		
Wellbore Sections							
Section Des		Size (in)		Act Top, MD (ftKB)		Act Btm, MD (ftKB)	
SURFACE		12 1/4		12.0		695.0	
PRODUCTION		7 7/8		695.0		7,317.0	
Zone Statuses							
Zone Name	Status Date	Status		Job			
CODELL	12/5/2007	PR		DRILLING/COMPLETION - ORIGINAL, 10/13/2007 00:00			
Casing Strings							
Surface, 687.0ftKB							
Casing Description	Run Date	OD (in)	Wt/Len (l...	Grade	Top, MD (ft...	MD (ftKB)	
Surface	10/14/2007	8 5/8	24.00	J-55	12.0	687.0	
Production, 7,279.0ftKB							
Casing Description	Run Date	OD (in)	Wt/Len (l...	Grade	Top, MD (ft...	MD (ftKB)	
Production	10/17/2007	4 1/2	11.60	N-80	12.0	7,279.0	
Cement							
Description				Top Depth (ftKB)		Bottom Depth (ftKB)	
SURFACE CASING CEMENT				12.0		687.0	
Description				Top Depth (ftKB)		Bottom Depth (ftKB)	
PRODUCTION CASING CEMENT				6,328.0		7,279.0	
Tubing Components							
Item Des	OD (in)	Wt (lb/ft)	Grade	Jts	Len (ft)	Btm (ftKB)	Btm (TVD) (ftKB)
Tubing	2 3/8	4.70	J-55	224	7,155.40	7,167.4	
Pump Seating	2 3/8			1	1.00	7,168.4	
Nipple							
Notched collar	2 3/8			1	0.60	7,169.0	
Perforation Data							
Zone	Bnch/St g	Entered Shot Total	Top (ftKB)	Btm (ftKB)	Date		
CODELL, ORIGINAL HOLE		52	7,151.00	7,164.00	11/27/2007		
Stimulations & Treatments							
Date	Zone	Primary Job Type					
12/1/2007	CODELL, ORIGINAL HOLE	DRILLING/COMPLETION - ORIGINAL					
Technical Result		Tech Result Details			Tech Result Note		
Comment							
Other In Hole							
Run Date	Des			OD (in)	Top (ftKB)	Btm (ftKB)	
Logs							
Date	Type				Top, MD (ftKB)	Btm, MD (ftKB)	
10/17/2007	COMPENSATED DENSITY				3,750.0	7,293.0	
10/17/2007	INDUCTION				675.0	7,313.0	
11/27/2007	CBL/CCL/GR				6,200.0	7,243.0	