


Well Name: PEPPLER 17-33

VERTICAL - ORIGINAL HOLE, 12/17/2014 1:04:20 PM

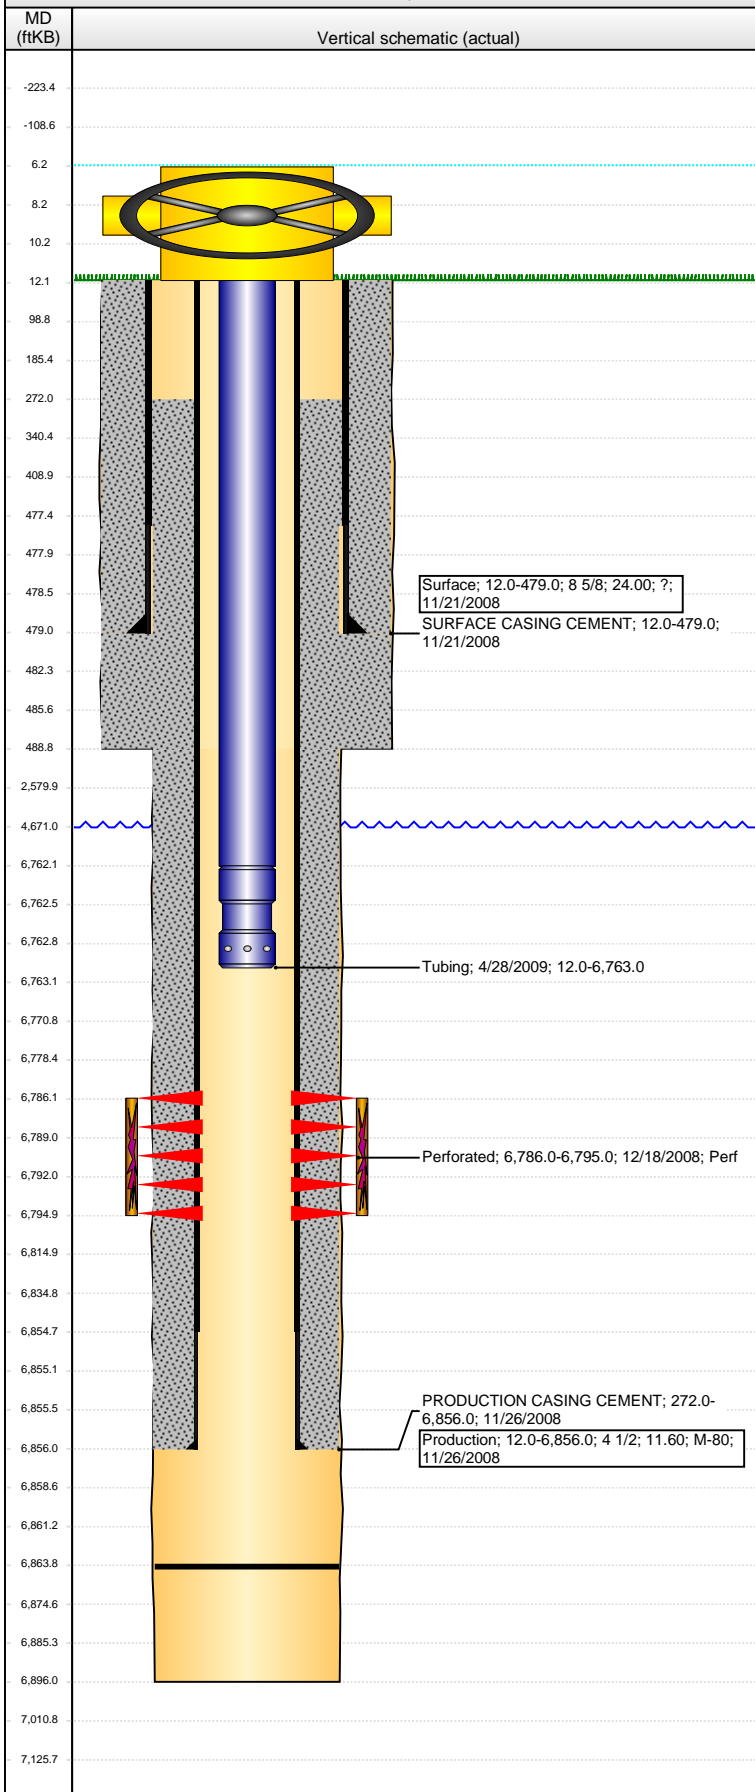

Well Header

API	Business Unit	District	Well Config
05-123-24309	DJ BASIN	15	VERTICAL
Original KB Elevation (ft)	KB - GL / MSL (ftKB)	Spud Date	P & A Date
4,677.00	12.00	11/18/2008	

Comment
WELL STARTS DEVIATING AROUND 6500', GYRO INDICATES AT MOST 9 DEGREES AT 6700'.

PRODUCTION CSG SET DEPTH/TD PROBABLY DEEPER BASED ON PBTD
Directions To Well

Congressional Location

Quarter 1	Quarter 2	Quarter 3	Quarter 4	Section	Township	Twship N...	Range	Rng E/W Dir
		SW	SW	17	6	N	63	W

Bottom Hole Location

North-South Distance (ft)	From N or S Line	East-West Distance (ft)	From E or W Line

Plug Back Total Depths

Date	Depth (ftKB)	Method	Com
12/15/2008	6,860.0	CASED HOLE LOG	DEPTH LOGGER ON CBL
4/28/2009	6,864.0	TAG	CLEAN OUT TO LAND TUBING

Wellbore Sections

Section Des	Size (in)	Act Top, MD (ftKB)	Act Btm, MD (ftKB)
SURFACE	12 1/4	12.0	489.0
PRODUCTION	7 7/8	489.0	6,896.0

Zone Statuses

Zone Name	Status Date	Status	Job
CODELL	1/15/2009	PR	DRILLING/COMPLETION - ORIGINAL, 11/18/2008 00:00

Casing Strings

Surface, 479.0ftKB

Casing Description	Run Date	OD (in)	Wt/Len (l...)	Grade	Top, MD (ft...)	MD (ftKB)
Surface	11/21/2008	8 5/8	24.00	?	12.0	479.0

Production, 6,856.0ftKB

Casing Description	Run Date	OD (in)	Wt/Len (l...)	Grade	Top, MD (ft...)	MD (ftKB)
Production	11/26/2008	4 1/2	11.60	M-80	12.0	6,856.0

Cement

Description	Top Depth (ftKB)	Bottom Depth (ftKB)
SURFACE CASING CEMENT	12.0	479.0
PRODUCTION CASING CEMENT	272.0	6,856.0

Tubing Components

Item Des	OD (in)	Wt (lb/ft)	Grade	Jts	Len (ft)	Btm (ftKB)	Btm (TVD) (ftKB)
Tubing	2 3/8			208	6,750.00	6,762.0	
Seal Nipple	2 3/8			1	1.00	6,763.0	

Perforation Data

Zone	Bnch/St g	Entered Shot Total	Top (ftKB)	Btm (ftKB)	Date
CODELL, ORIGINAL HOLE		36	6,786.00	6,795.00	12/18/2008

Stimulations & Treatments

Date	Zone	Primary Job Type
12/19/2008	CODELL, ORIGINAL HOLE	DRILLING/COMPLETION - ORIGINAL
Technical Result	Tech Result Details	Tech Result Note

Comment

Other In Hole

Run Date	Des	OD (in)	Top (ftKB)	Btm (ftKB)

Logs

Date	Type	Top, MD (ftKB)	Btm, MD (ftKB)
11/26/2008	COMPENSATED DENSITY	479.0	6,876.0
11/26/2008	INDUCTION	479.0	6,896.0
12/15/2008	CBL/CCL/GR	12.0	6,859.0
12/17/2008	PERFORATE	12.0	6,859.0