


I, DAVID A. FEHRINGER OF LANDER, WYOMING HEREBY CERTIFY THAT THIS WELL LOCATION CERTIFICATE WAS PREPARED FROM NOTES TAKEN DURING AN ACTUAL SURVEY ON OCTOBER 9, 2014; AND THAT IT CORRECTLY SHOWS THE DRILLING LOCATION OF BONANZA CREEK ENERGY, INC., PRONGHORN 13-43-28HNC AS STAKED DURING SAID SURVEY. THIS MAP DOES NOT REPRESENT A BOUNDARY SURVEY OR AN IMPROVEMENT LOCATION PLAT AND SHOULD NOT BE USED FOR THE ESTABLISHMENT OF BOUNDARY LINES.

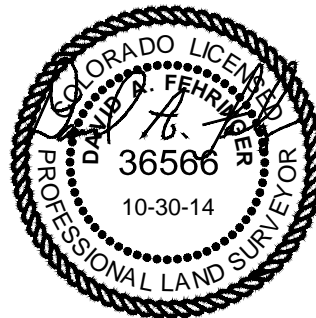


BOTTOM HOLE LOCATION:
GEODETIC COORDINATES
LAT = N40.37001°
LONG = W104.20622°

STATE PLANE (CO-N NAD83)
N= 1,380,203.50'
E= 3,360,502.03'



Drawn By: KDWK
Checked By: DAF
Date: 10-13-2014
Revision: Well location
Date: 10-28-2014
Explanation: Well locations were modified by Bonanza.

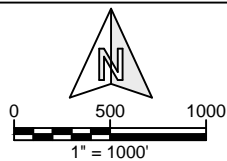

IF BAR LENGTH DOES NOT EQUAL
1*(ONE INCH), THIS PAGE WAS NOT
PLOTTED TO THE INTENDED SCALE

PRONGHORN 13-43-28HNC
SW $\frac{1}{4}$ SW $\frac{1}{4}$, SECTION 28,
T.5N., R.61W., 6th PM
WELD COUNTY, COLORADO



410 17TH STREET
DENVER, CO 80202
(720) 440-6100

1