


**KERR-MCGEE OIL AND GAS ONSHORE LP**  
**UPRC 19-10L**  
**NW SE 19 3N 67W 1,968' FSL 1,979' FEL**  
**WELD,COLORADO**  
**12/17/2014**

AREA: N2      ROUTE: N21    Spud: 09/28/1993    WINS No.: 23595    AFE/WO#: 2103679    API#: 0512317444

GL: 4900    KB: 4913    MTD:    TVD:    LOG MD:    PBMD: 7306    PBTVD:

Directions: CR 32 & CR 13, E 5/10, S 6/10, E 1/10 INTO

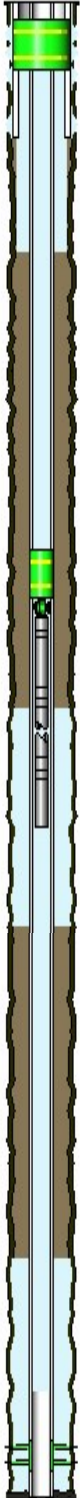

<u>HOLE SECTIONS</u>		<u>Size</u>	<u>Top</u>	<u>Btm</u>	<u>TD Date</u>			
SURFACE		8.62	13	510	09/18/1993			
PRODUCTION		7.88	13	7359	09/28/1993			
<u>TUBULARS</u>	<u>Tool Type</u>	<u>Joints</u>	<u>Size</u>	<u>Weight</u>	<u>Grade</u>	<u>Thread</u>	<u>Top D</u>	<u>Bottom D</u>
SURFACE CASING								
	Casing	12	8.63	23.00			13	510
PRODUCTION CASING								
	Casing	178	3.50	7.70	M75	8RD	13	7360
2-1/16 J TUBING								
	Fish						3000	3000
CAST IRON CEMENT RETAINER								
	Cement Retainer	1	3.50				2995	2997
BRIDGE PLUG								
	Cast Iron Bridge Plu	1	8.63				95	97
<u>CEMENT JOBS</u>	<u>Stage</u>	<u>Sacks</u>	<u>Cement Jobs</u>			<u>Top D</u>	<u>Btm D</u>	<u>cbl</u>
SURFACE CASING								
	PRIM CMT 1ST STAGE	241	LEAD	CEMENT		13	510	No
PRODUCTION CASING								
	PRIM CMT 2ND STAGE	390	LEAD	CEMENT		3610	4750	Yes
	PRIM CMT 1ST STAGE	173	TAIL	CEMENT		6354	7360	Yes
PRODUCTION CASING								
	ABANDONMENT PLUC	100	LEAD	FRESH WATER		2850	6995	No
PRODUCTION CASING								
	ABANDONMENT PLUC	80	LEAD	FRESH WATER		1200	2850	No
SURFACE CASING								
	ABANDONMENT PLUC	290	LEAD	FRESH WATER		480	1200	No
SURFACE CASING								
	ABANDONMENT PLUC	70	LEAD	FLOC WATER		190	480	No
<u>PERFORATIONS</u>								
<u>Formation</u>	<u>Zone</u>	<u>Top</u>	<u>Btm</u>	<u>Date</u>	<u>Reason</u>	<u>Comments</u>		
CODELL		7229	7239	10/27/1993	PRODUCTION			
CODELL		7229	7248	02/20/2005	PRODUCTION			

Comments: