

KERR-MCGEE OIL AND GAS ONSHORE LP

**RADEMACHER 12-30
NW SW 30 3N 67W -- --
WELD,COLORADO
12/17/2014**

AREA: W2

ROUTE: W24 Spud: 01/14/1995

WINS No.: 74634

AFE/WO#: 2103354

API#: 0512318846

GL: 4856

KB: 4866

MTD: 7337


TVD: 7337

LOG MD: 7335

PBMD: 7298

PBTVD: 7298

Directions: WCR 13 & WCR 28, N 1/10, E 3/10, N 1/2, W 1/10 INTO

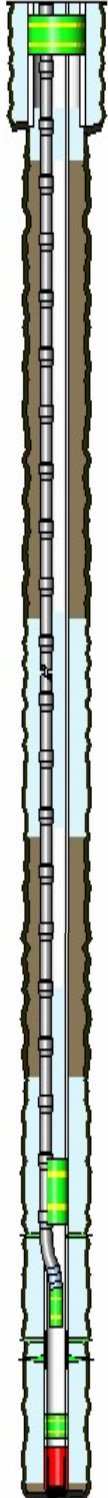

<u>HOLE SECTIONS</u>	<u>Size</u>	<u>Top</u>	<u>Btm</u>	<u>TD Date</u>
SURFACE	12.25	10	755	
PRODUCTION	7.88	755	7337	

<u>TUBULARS</u>	<u>Tool Type</u>	<u>Joints</u>	<u>Size</u>	<u>Weight</u>	<u>Grade</u>	<u>Thread</u>	<u>Top D</u>	<u>Bottom D</u>
SURFACE CASING	Casing	17	8.63	23.00	J-55	STC	10	742
PRODUCTION CASING	Casing	180	3.50	7.70	KS-70	10RD IJ	10	7298
	Baffle	1	3.50				7298	7298
	Casing	1	3.50	7.70	KS-70		7298	7335
	Casing Guide Shoe	1	3.50				7335	7336
PRODUCTION TUBING	Tubing	219	2.06	3.25	J-55	10RD IJ	10	7172
	Seating Nipple	1	2.06				7172	7174
	Notched Collar	1	2.06				7174	7174
BRIDGE PLUG	Cast Iron Bridge Plu	1	3.50				6920	6922
BRIDGE PLUG	Cast Iron Bridge Plu	1	8.63				90	92

<u>CEMENT JOBS</u>	<u>Stage</u>	<u>Sacks</u>	<u>Cement Jobs</u>	<u>Top D</u>	<u>Btm D</u>	<u>cbf</u>
SURFACE CASING	PRIM CMT 1ST STAGE	520	LEAD NEAT	10	755	No
PRODUCTION CASING	PRIM CMT 1ST STAGE	445	LEAD CLASS G	3686	5000	Yes
	PRIM CMT 1ST STAGE	185	TAIL 85/15 POZ-MIX	6430	7336	Yes
PRODUCTION CASING	ABANDONMENT PLUC	50	LEAD FRESH WATER	3850	4950	No
PRODUCTION CASING	ABANDONMENT PLUC	40	LEAD FRESH WATER	5900	6920	No
PRODUCTION CASING	ABANDONMENT PLUC	25	LEAD FRESH WATER	3650	4150	No
SURFACE CASING	ABANDONMENT PLUC	180	LEAD FRESH WATER	640	950	No
SURFACE CASING	ABANDONMENT PLUC	45	LEAD FRESH WATER	12	90	No

<u>PERFORATIONS</u>	<u>Formation</u>	<u>Zone</u>	<u>Top</u>	<u>Btm</u>	<u>Date</u>	<u>Reason</u>	<u>Comments</u>
	NIOBRARA	B	6985	6986	02/03/1995	PRODUCTION	
	CODELL		7190	7210	01/06/2010	PRODUCTION	
	CODELL		7195	7200	02/03/1995	PRODUCTION	

Comments: