

WPX Energy Rocky Mountain LLC

SAVAGE RWF 444-25


RULISON Field

SHL: 1125' FSL 1381' FEL (SW/4 SE/4) Section 25 T6S R94W 6th PM

BHL: 405' FSL 709' FEL (SE/4 SE/4) Section 25 T6S R94W 6th PM

Garfield County Colorado

Formation Tops
(Measured Depths)

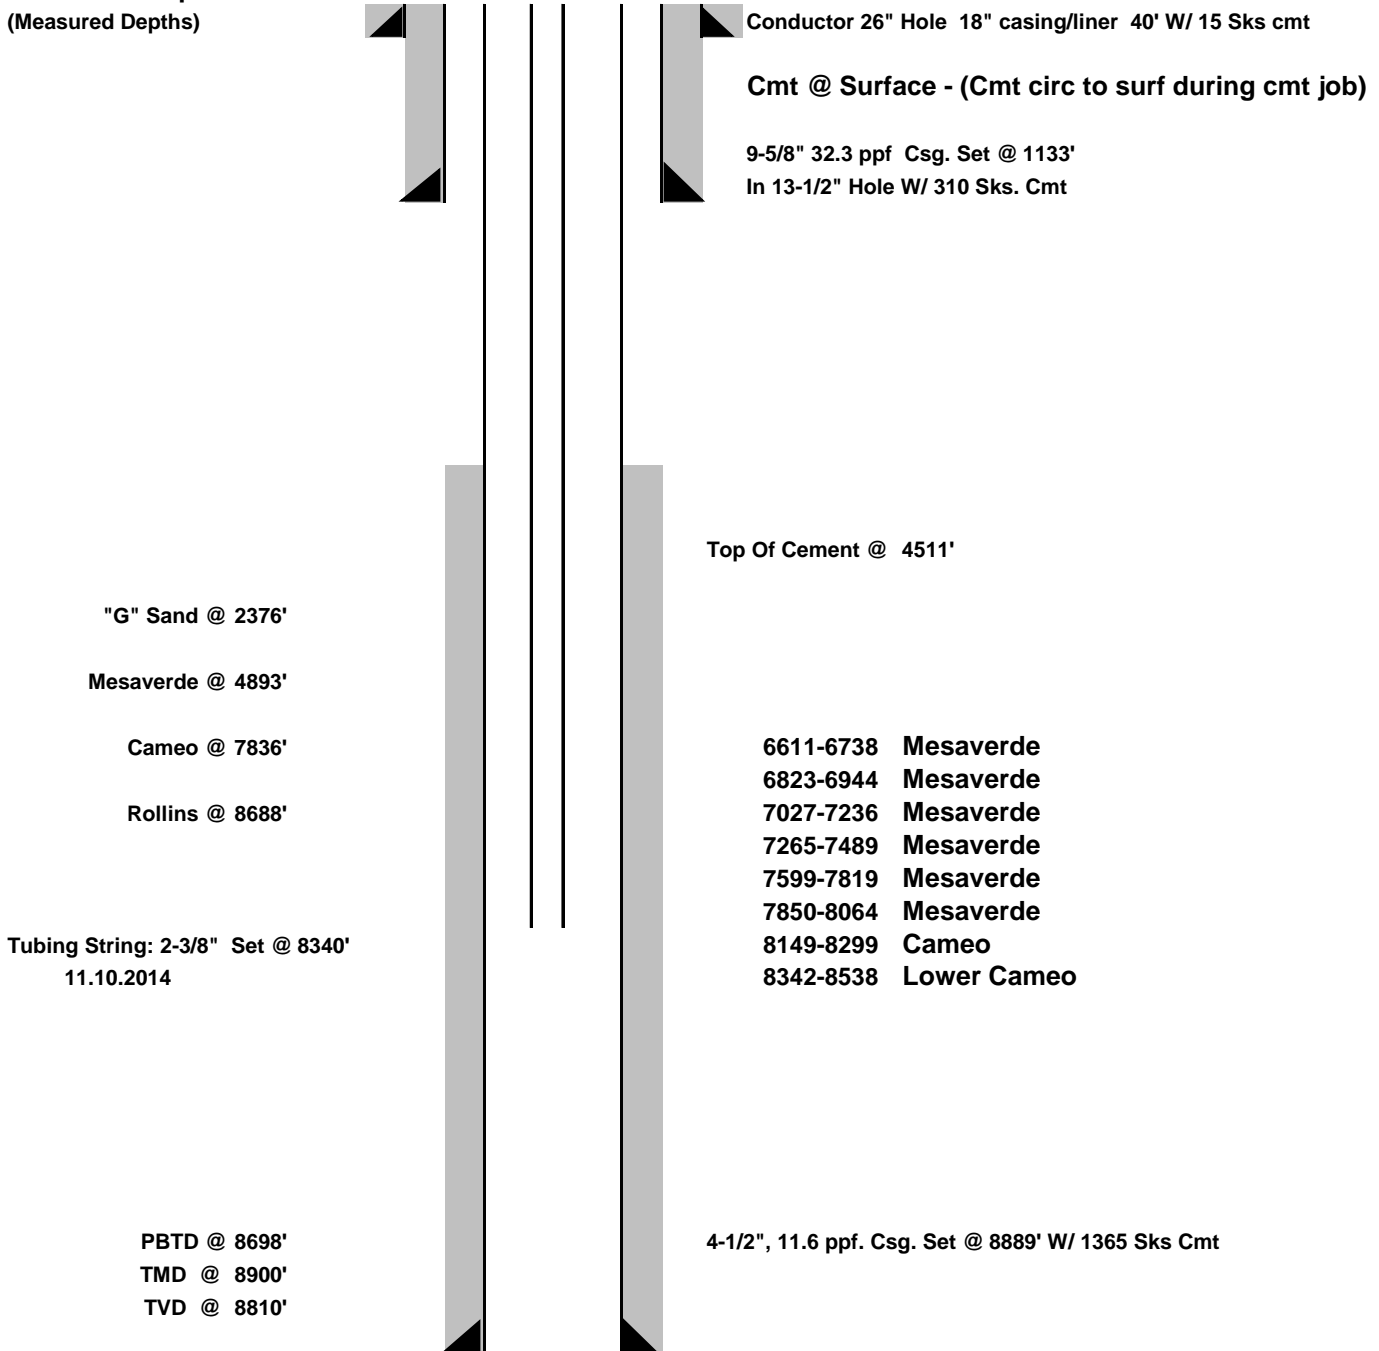

DATE CREATED: 12.18.2014

NOTE: THIS IS NOT TO SCALE.
****FINAL****