


WPX Energy Rocky Mountain LLC  
CHEVRON GM 12-21  
GRAND VALLEY Field

SHL: 2034' FNL 703' FEL (SE/4 NE/4) Section 20 T6S R96W 6th PM  
BHL: 1392' FNL 1011' FWL (SW/4 NW/4) Section 21 T6S R96W 6th PM  
Garfield County Colorado

Formation Tops  
(Measured Depths)

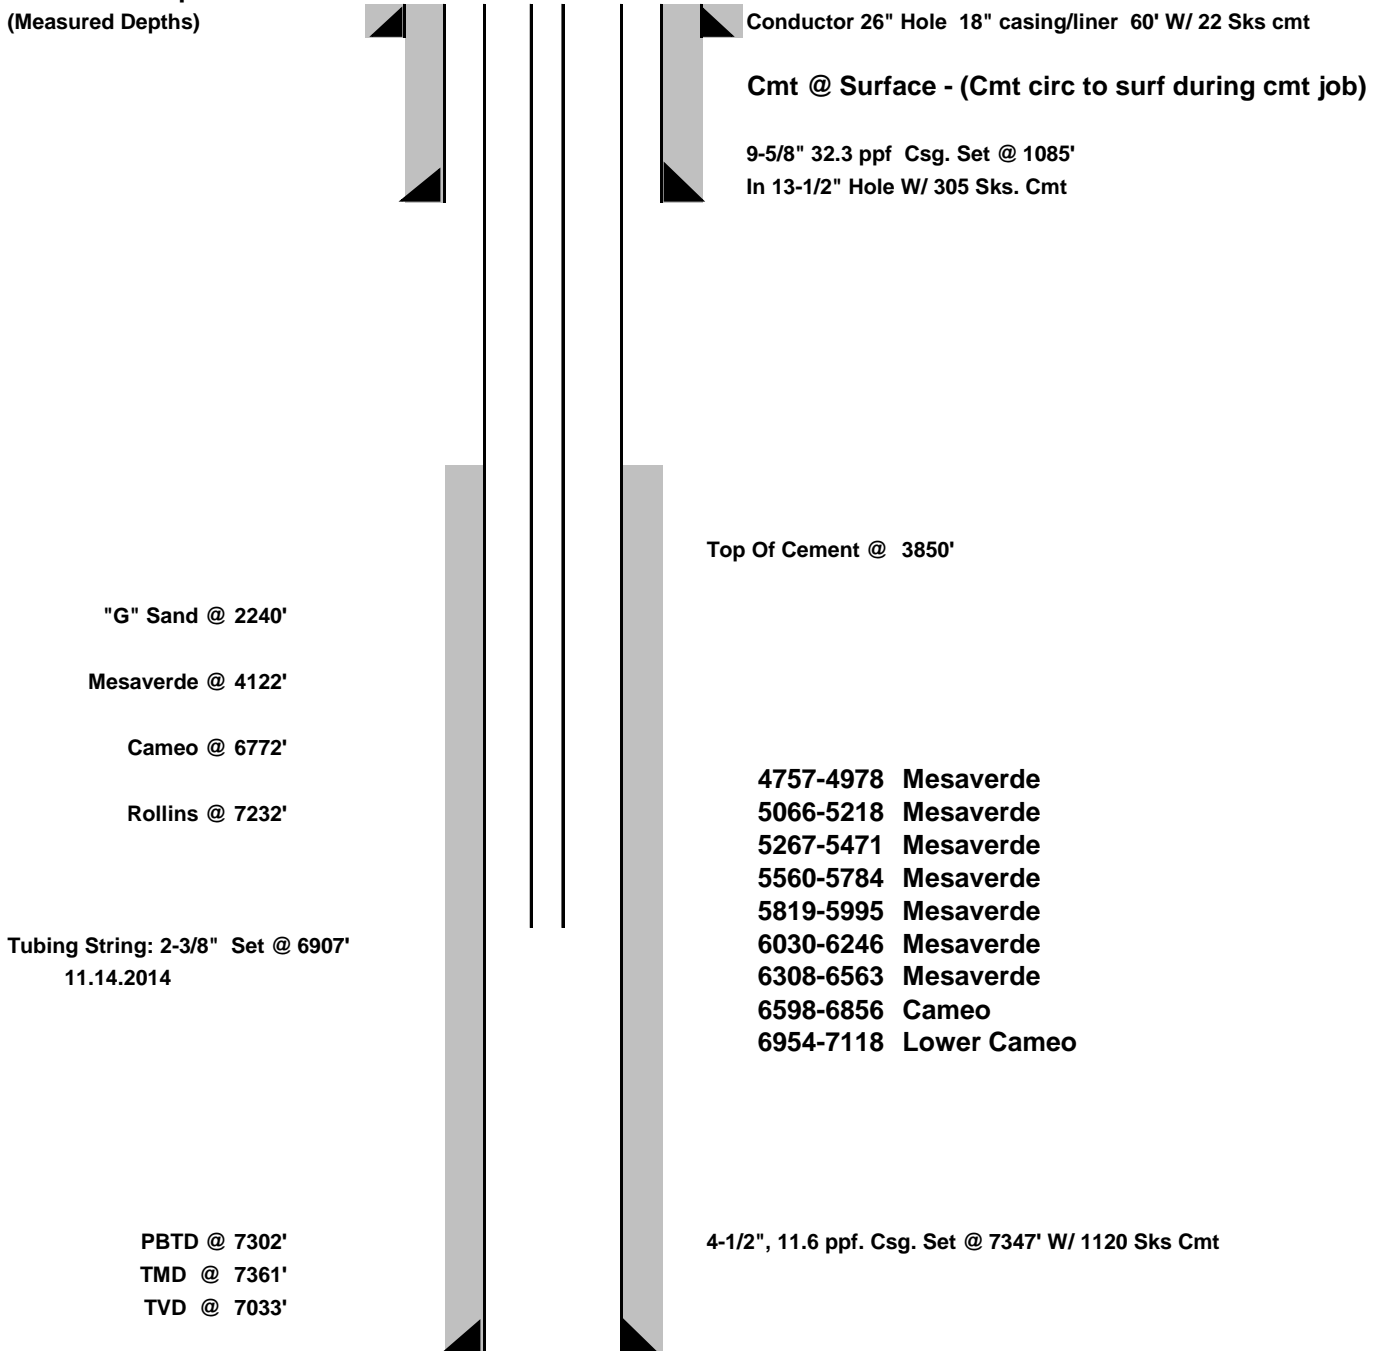

DATE CREATED: 12.17.2014

NOTE: THIS IS NOT TO SCALE.  
\*\*FINAL\*\*