


**Well Name: STATE 36-11E**

VERTICAL - ORIGINAL HOLE, 12/29/2014 9:55:41 AM

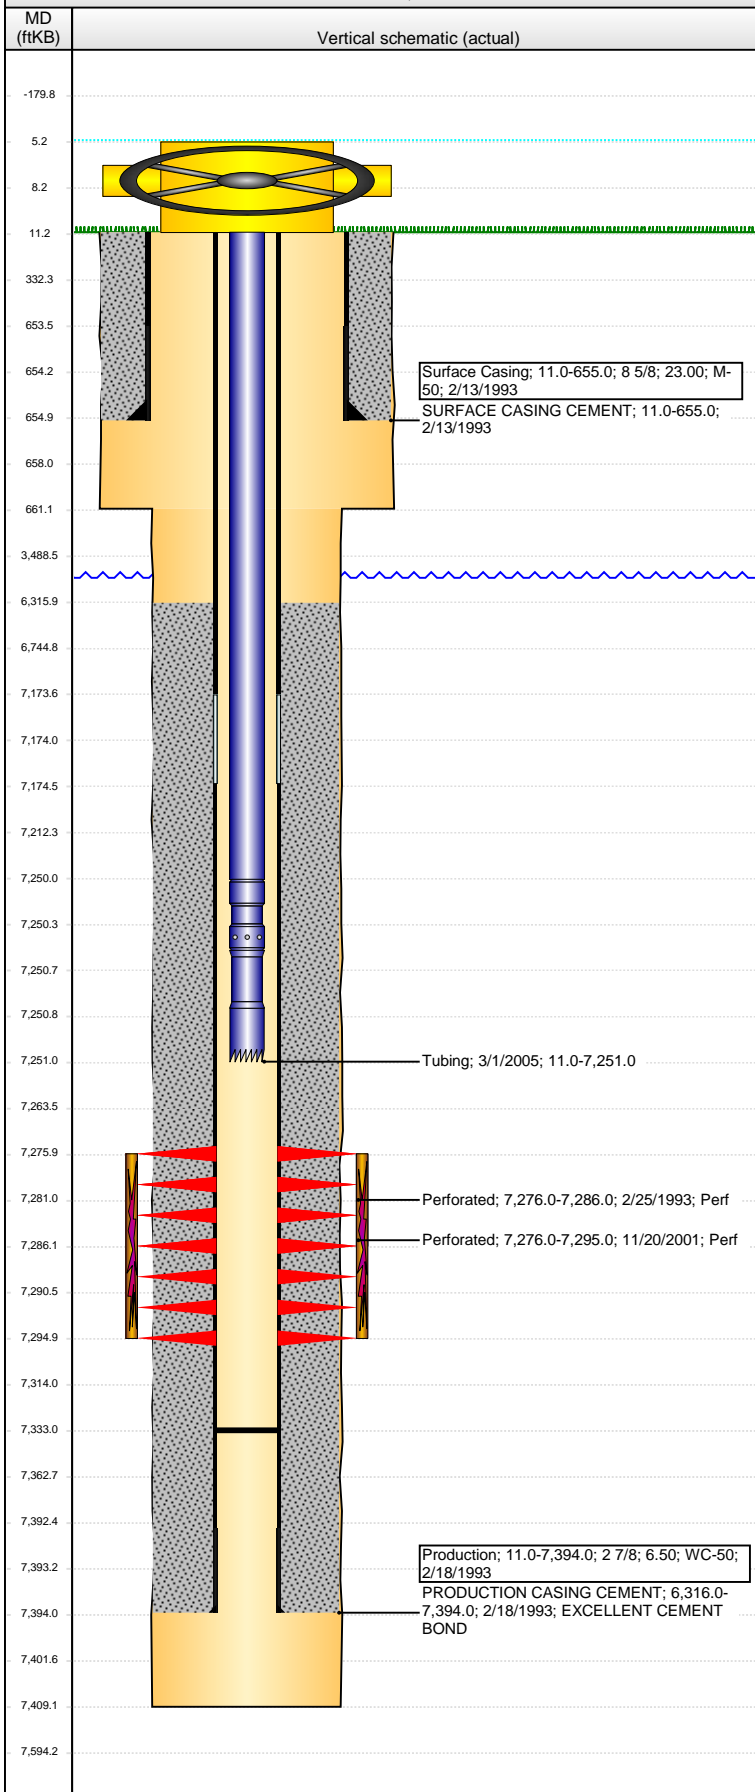

## Well Header

API	Business Unit	District	Well Config
05-123-16745	DJ BASIN	15	VERTICAL
Original KB Elevation (ft)	KB - GL / MSL (ftKB)	Spud Date	P & A Date
4,780.00	11.00	2/13/1993	

## Comment

st lse 70-8158, frac'd into 36-14E  
DISCREPANCY -- DR RPT TD 7395; ST RPT TD 7409

## Directions To Well

## Congressional Location

Quarter 1	Quarter 2	Quarter 3	Quarter 4	Section	Township	Twnshp N...	Range	Rng E/W Dir
		NE	SW	36	4	N	67	W

## Bottom Hole Location

North-South Distance (ft)	From N or S Line	East-West Distance (ft)	From E or W Line
---------------------------	------------------	-------------------------	------------------

## Plug Back Total Depths

Date	Depth (ftKB)	Method	Com
3/1/2005	7,333.0	TAG	LAST CLEANOUT

## Wellbore Sections

Section Des	Size (in)	Act Top, MD (ftKB)	Act Btm, MD (ftKB)
SURFACE	12 1/4	11.0	661.0
PRODUCTION	7 7/8	661.0	7,409.0

## Zone Statuses

Zone Name	Status Date	Status	Job
CODELL	3/15/1993	PR	DRILLING/COMPLETION - ORIGINAL, 2/13/1993 00:00
CODELL	12/14/2001	PR	RE-FRAC, 11/17/2001 00:00

## Casing Strings

### Surface Casing, 655.0ftKB

Casing Description	Run Date	OD (in)	Wt/Len (l...)	Grade	Top, MD (ft...)	MD (ftKB)
Surface Casing	2/13/1993	8 5/8	23.00	M-50	11.0	655.0

### Production, 7,394.0ftKB

Casing Description	Run Date	OD (in)	Wt/Len (l...)	Grade	Top, MD (ft...)	MD (ftKB)
Production	2/18/1993	2 7/8	6.50	WC-50	11.0	7,394.0

## Cement

Description	Top Depth (ftKB)	Bottom Depth (ftKB)
SURFACE CASING CEMENT	11.0	655.0
Description	Top Depth (ftKB)	Bottom Depth (ftKB)
PRODUCTION CASING CEMENT	6,316.0	7,394.0

## Tubing Components

Item Des	OD (in)	Wt (lb/ft)	Grade	Jts	Len (ft)	Btm (ftKB)	Btm (TVD) (ftKB)
Tubing	1 1/2	2.76	J-55	217	7,238.90	7,249.9	
Seal Nipple	1 1/2			1	0.60	7,250.5	
Notched collar	1 1/2			1	0.50	7,251.0	

## Perforation Data

Zone	Bnch/St g	Entered Shot Total	Top (ftKB)	Btm (ftKB)	Date
CODELL, ORIGINAL HOLE		72	7,276.00	7,295.00	11/20/2001
CODELL, ORIGINAL HOLE		20	7,276.00	7,286.00	2/25/1993

## Stimulations & Treatments

Date	Zone	Primary Job Type
2/26/1993	CODELL, ORIGINAL HOLE	DRILLING/COMPLETION - ORIGINAL
Technical Result	Tech Result Details	Tech Result Note

## Comment

Date	Zone	Primary Job Type
11/28/2001	CODELL, ORIGINAL HOLE	RE-FRAC
Technical Result	Tech Result Details	Tech Result Note

## Comment

## Other In Hole

Run Date	Des	OD (in)	Top (ftKB)	Btm (ftKB)

## Logs

Date	Type	Top, MD (ftKB)	Btm, MD (ftKB)