

KERR-MCGEE OIL AND GAS ONSHORE LP

**MUHME 6-30A
SE NW 30 3N 67W -- --
WELD,COLORADO
12/19/2014**

AREA: W2

ROUTE: W24 Spud: 01/28/1995

WINS No.: 74636

AFE/WO#: 88603857

API#: 0512318851

GL: 4867

KB: 4877

MTD: 7750


TVD: 7750

LOG MD:

PBMD: 7705

PBTVD: 7705

Directions: CR 28 & CR 13, N 1/10, E 5/10, N 4/10, W INTO.

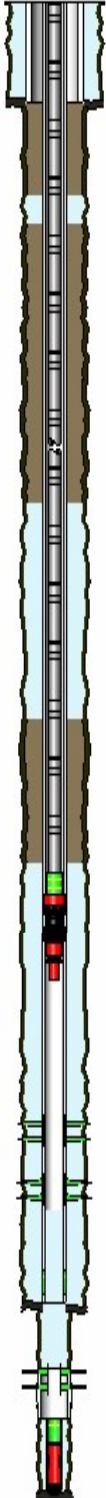

<u>HOLE SECTIONS</u>	<u>Size</u>	<u>Top</u>	<u>Btm</u>	<u>TD Date</u>			
SURFACE	12.25	10	736	01/29/1995			
PRODUCTION	7.88	736	7327	02/01/1995			
DEEPEMED	2.75	7327	7750	03/21/2001			

<u>TUBULARS</u>	<u>Tool Type</u>	<u>Joints</u>	<u>Size</u>	<u>Weight</u>	<u>Grade</u>	<u>Thread</u>	<u>Top D</u>	<u>Bottom D</u>
SURFACE CASING	Casing	17	8.63	23	J-55		10	732
PRODUCTION CASING	Casing	179	3.50	7.7	KS-70/80		10	7260
		1	3.50				7260	7262
	Casing	1	3.50	7.7	KS-70/80		7262	7299
	Casing Guide Shoe	1	3.50				7299	7230
DEEPEMED LINER	Liner Hanger	1					7213	7217
		16	2.38	4.7	N-80	HYDRILL	7217	7705
		1	2.38				7705	7707
		1	2.38	4.7	N-80	HYDRILL	7707	7735
	Casing Guide Shoe	1	2.38				7735	7736
PACKER	Tubing	193	2.06	3.25	J-55	Integral-Joi	10	6341
	XN Profile Nipple	1					6341	6342
	Packer	1	3.50				6342	6348

<u>CEMENT JOBS</u>	<u>Stage</u>	<u>Sacks</u>	<u>Cement Jobs</u>	<u>Top D</u>	<u>Btm D</u>	<u>cbl</u>
SURFACE CASING	STAGE 1	510	NEAT	10	736	No
DEEPEMED LINER	STAGE 1	30	G	7213	7750	Yes
PRODUCTION CASING	SQUEEZE 1	200	PREMIUM	1404	1619	Yes
	STAGE 1			4047	5210	Yes
	STAGE 1 TAIL			6268	7327	Yes
PRODUCTION CASING	ABANDONMENT PLUC	20	LEAD FRESH WATER	4177	4209	No
PRODUCTION CASING	SQUEEZE JOB	25	LEAD FRESH WATER	3648	4242	No
PRODUCTION CASING	REMEDIAL CEMENT	20	LEAD FRESH WATER	3805	4242	No

<u>PERFORATIONS</u>	<u>Formation</u>	<u>Zone</u>	<u>Top</u>	<u>Btm</u>	<u>Date</u>	<u>Reason</u>	<u>Comments</u>
	NIORARA		7041	7042	02/09/1995	PRODUCTION	
	CODELL		7184	7189	02/09/1995	PRODUCTION	
	J SAND		7612	7634	03/30/2001	PRODUCTION	

Comments: