

WPX Energy Rocky Mountain LLC

CHEVRON GM 512-21


GRAND VALLEY Field

SHL: 2057' FNL 704' FEL (SE/4 NE/4) Section 20 T6S R96W 6th PM

BHL: 2282' FNL 1014' FWL (SW/4 NW/4) Section 21 T6S R96W 6th PM

Garfield County Colorado

Formation Tops
(Measured Depths)

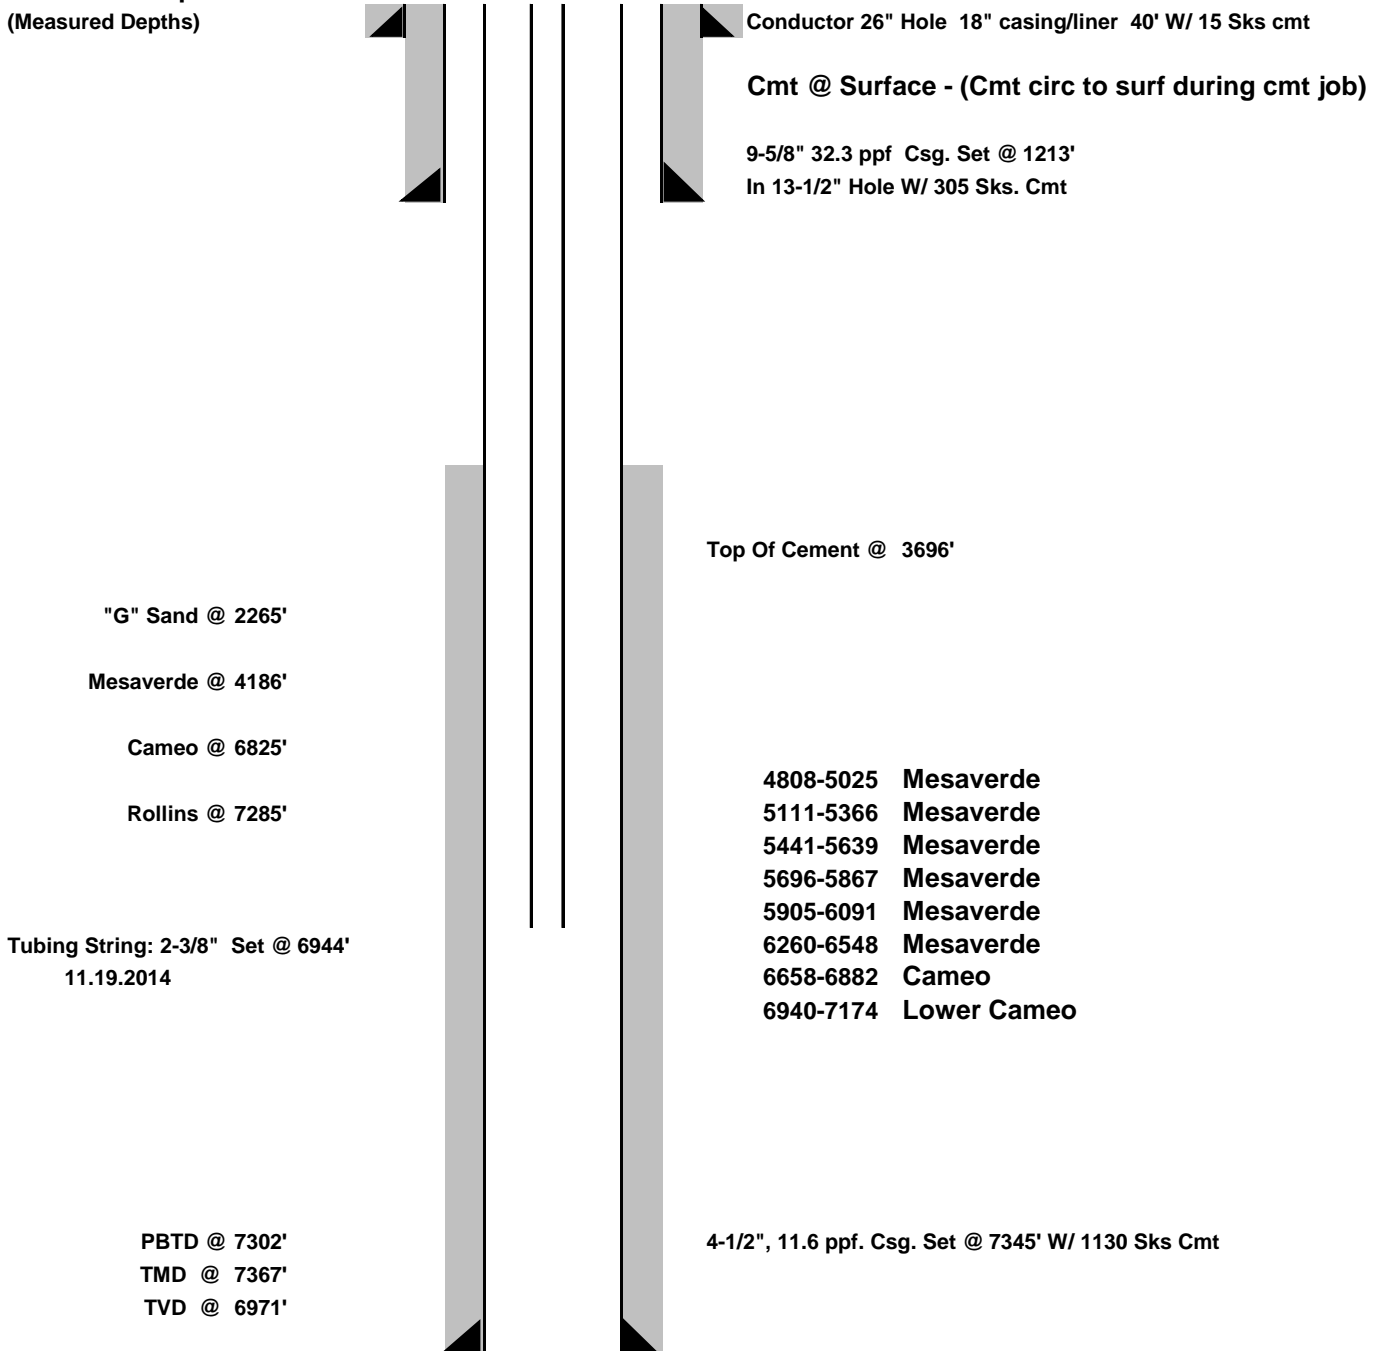

DATE CREATED: 12.18.2014

NOTE: THIS IS NOT TO SCALE.
****FINAL****