



Memorandum

To: Well File

From: Mark Weems, P.E.
Regional Engineer - SW Colorado

Date: January 5, 2015

Subject: A Well Permitting, Drilling and Completion History

Conclusion:

This well has been temporarily abandoned for more than two (2) years and will require a mechanical integrity test (MIT) as per rule 319 (b) (1). This information has been forwarded to the appropriate COGCC personnel to notify the operator.

BP

**Eldridge 25-02 #2
NESW 25 33N 11W
API #067-09567-01**

6/2/2008

APD approved doc #1977691
S-shaped directional well bore
API #067-09567-00

10/8/2008

Drilling Completion Report doc #1937890
Sundry Notice doc #1937891
Drill string stuck at 3390'
7 5/8" OD csg set at 2830' (2856' form 5) due to sloughing well bore and cmt'd to surf
Drill out to 3390'
Fish left in hole
Six (6) jts DP+bit 3199'-3390'
Three (3) jts DP+bit 2925'-2950'
Cmt plug 2950'-2380'
CIBP at 1350'

12/22/2009

APD approved doc #1774335
Sidetrack
API #067-09567-01

11/12/2010

APD re-file/sidetrack approved doc #2584486

API #067-09567-01

12/23/2012

APD re-file/sidetrack approved doc #400349331

API #067-09567-01

12/22/2014

APD re-file/sidetrack approved doc #400751825

API #067-09567-01

RECEIVED


NOV 06 2008

Temporary Abandonment - Eldridge 25-2 #2 - 05-067-09567-00

NESW SECTION 25, T33N, R11W - SPUD 9/28/2008 - TEMP ABANDON 10/15/2008

Backpressure valve in 7 5/8" mandrel hanger

14 1/2" hole
10 3/4" surface casing - 387'

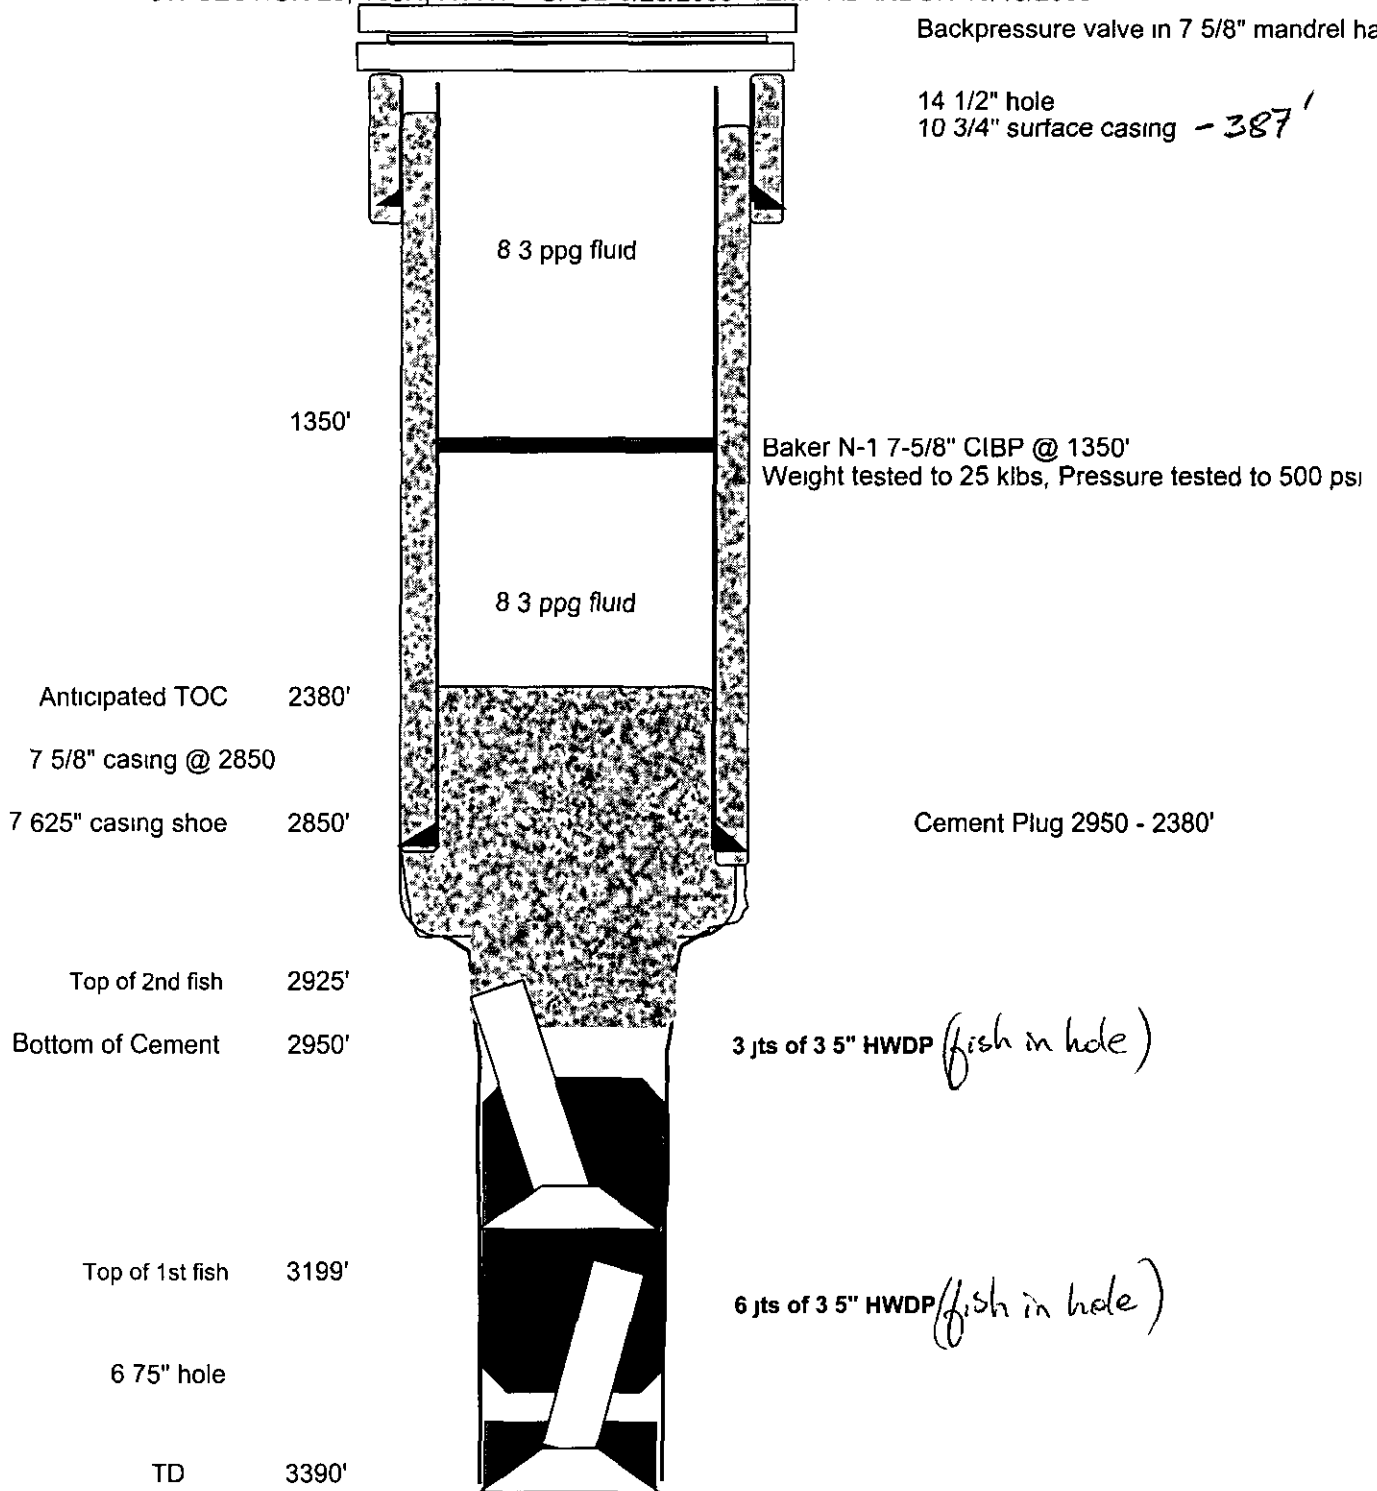



067-09567

RECEIVED
NOV 12 2009
COGCC

Well Name: Eldridge 25-02 #2

API #: 05-067-09567-00

BHL: 1149' FSL, 1492' FWL

Location: SEC. 25U, T33N, R11W La Plata County, Colorado

Elevation: 6517' GL, KB 6533'

