


KERR-MCGEE OIL AND GAS ONSHORE LP
DOLPH 33-1
SW SW 1 2N 66W 51S FSL 575' FWL
WELD, COLORADO
01/06/2015

AREA: E2 ROUTE: E21 Spud: 10/09/2009 WINS No.: 26665 AFE/WO#: 2101169 API#: 0512329686

GL: 5018 KB: 5035 MTD: 8162 TVD: 8047 LOG MD: PBMD: 8114 PBTVD: 7999

Directions: WCR 22 & WCR 37 N 1 4/10, W 6/10, S 2/10, W 2/10 INTO

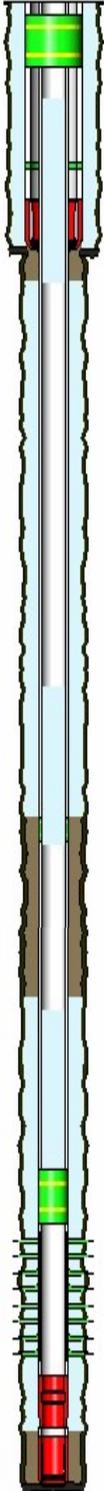

<u>HOLE SECTIONS</u>		<u>Size</u>	<u>Top</u>	<u>Btm</u>	<u>TD Date</u>				
SURFACE		12.25	17	940	10/09/2009				
PRODUCTION		7.88	940	8162	10/11/2009				
<u>TUBULARS</u>		<u>Tool Type</u>	<u>Joints</u>	<u>Size</u>	<u>Weight</u>	<u>Grade</u>	<u>Thread</u>	<u>Top D</u>	<u>Bottom D</u>
SURFACE CASING									
	Casing	20	8.63	24.00	J-55	STC	17	885	
	Baffle	1	8.63		J55		885	885	
	Casing	1	8.63	24.00	J-55	STC	885	930	
	Casing Guide Shoe	1	8.63		J55		930	931	
PRODUCTION CASING									
	Casing	127	4.50	11.60	I-80	8RD LTC	17	5370	
	Cement Stage Too	1	4.50		I-80		5370	5372	
	Casing	66	4.50	11.60	I-80	8RD LTC	5372	8114	
	Casing Float Collar	1	4.50		I-80		8114	8116	
	Casing	1	4.50	11.60	I-80	8RD LTC	8116	8150	
	Casing Float Shoe	1	4.50		I-80		8150	8152	
BRIDGE PLUG									
	Cast Iron Bridge Plu	1	4.50				7950	7951	
BRIDGE PLUG									
	Cast Iron Bridge Plu	1	8.63				80	82	
<u>CEMENT JOBS</u>		<u>Stage</u>	<u>Sacks</u>	<u>Cement Jobs</u>		<u>Top D</u>	<u>Btm D</u>	<u>cbl</u>	
SURFACE CASING									
	PRIM CMT 1ST STAGE	590	TAIL	TYPE 3		17	940	No	
PRODUCTION CASING									
	PRIM CMT 1ST STAGE	190	TAIL	50/50 POZ-MIX		6868	8125	Yes	
	PRIM CMT 2ND STAGE	400	LEAD	35/65 POZ-MIX		1140	5280	Yes	
	PRIM CMT 2ND STAGE	50	MIDDLE	NEAT		5280	5370	Yes	
PRODUCTION CASING									
	ABANDONMENT PLUC	65	LEAD	FRESH WATER		6700	7950	No	
	ABANDONMENT PLUC	80	TAIL	FRESH WATER		4346	5400	No	
PRODUCTION CASING									
	ABANDONMENT PLUC	150	LEAD	FRESH WATER		510	1184	No	
<u>PERFORATIONS</u>									
<u>Formation</u>	<u>Zone</u>	<u>Top</u>	<u>Btm</u>	<u>Date</u>	<u>Reason</u>	<u>Comments</u>			
J SAND		8006	8012	11/11/2009	PRODUCTION				
J SAND		8022	8028	11/11/2009	PRODUCTION				
J SAND		8040	8050	11/11/2009	PRODUCTION				
J SAND		8058	8062	11/11/2009	PRODUCTION				

Comments: