


KERR-MCGEE OIL AND GAS ONSHORE LP
STATE L 16-16
SE SE 16 3N 66W 460' FSL 460' FEL
WELD,COLORADO
01/06/2015

AREA: N1 ROUTE: N14 Spud: 11/15/1990 WINS No.: C2513 AFE/WO#: 2099682 API#: 0512314843

GL: 4881 KB: 4891 MTD: 7500 TVD: 7500 LOG MD: PBMD: 7480 PBTVD:

Directions: CR 32 & CR 31, N 100', W 1/10 INTO

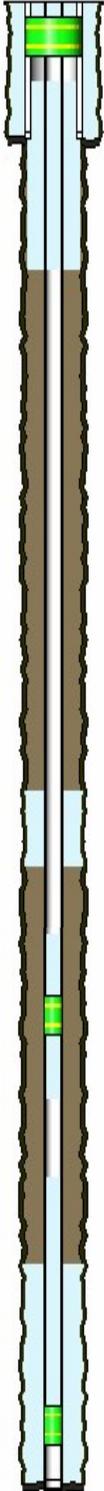

<u>HOLE SECTIONS</u>		<u>Size</u>	<u>Top</u>	<u>Btm</u>	<u>TD Date</u>				
SURFACE		12.25	10	550	11/15/1990				
PRODUCTION		7.88	550	7501	11/22/1990				
<u>TUBULARS</u>		<u>Tool Type</u>	<u>Joints</u>	<u>Size</u>	<u>Weight</u>	<u>Grade</u>	<u>Thread</u>	<u>Top D</u>	<u>Bottom D</u>
SURFACE CASING		Casing	12	8.63	24.00	?		10	539
		Casing	1	8.63				539	540
PRODUCTION CASING		Casing	241	2.88	6.50	?		10	7499
		Casing	1	2.88				7499	7501
CASING PATCH		Casing Patch		2.88				5242	5243
BRIDGE PLUG		Cast Iron Bridge Plu		2.88				7280	7282
BRIDGE PLUG		Cast Iron Bridge Plu	1	8.63				80	82
<u>CEMENT JOBS</u>		<u>Stage</u>	<u>Sacks</u>	<u>Cement Jobs</u>		<u>Top D</u>	<u>Btm D</u>	<u>cbl</u>	
SURFACE CASING		PRIM CMT 1ST STAGE	500	LEAD	CEMENT	10	540	No	
PRODUCTION CASING		PRIM CMT 1ST STAGE	350	LEAD	CEMENT	6500	7501	Yes	
BRIDGE PLUG		ABANDONMENT PLUC	20	LEAD	CEMENT	6025	7280	No	
PRODUCTION CASING		ABANDONMENT PLUC	320	LEAD	FRESH WATER	4120	4535	No	
PRODUCTION CASING		ABANDONMENT PLUC	20	LEAD	FRESH WATER	4900	5600	No	
SURFACE CASING		ABANDONMENT PLUC	640	LEAD	FRESH WATER	330	1260	No	
SURFACE CASING		ABANDONMENT PLUC	50	LEAD	FRESH WATER	10	80	No	
<u>PERFORATIONS</u>		<u>Formation</u>	<u>Zone</u>	<u>Top</u>	<u>Btm</u>	<u>Date</u>	<u>Reason</u>	<u>Comments</u>	
				4535	4536	12/14/2014	CEMENT SQUEEZE		
		CODELL		7349	7359	03/01/2003	PRODUCTION		
		CODELL		7350	7366	12/01/1990	PRODUCTION		

Comments: