


Kerr 28N-12 H2X WBD - Xtreme 24 Sidetrack

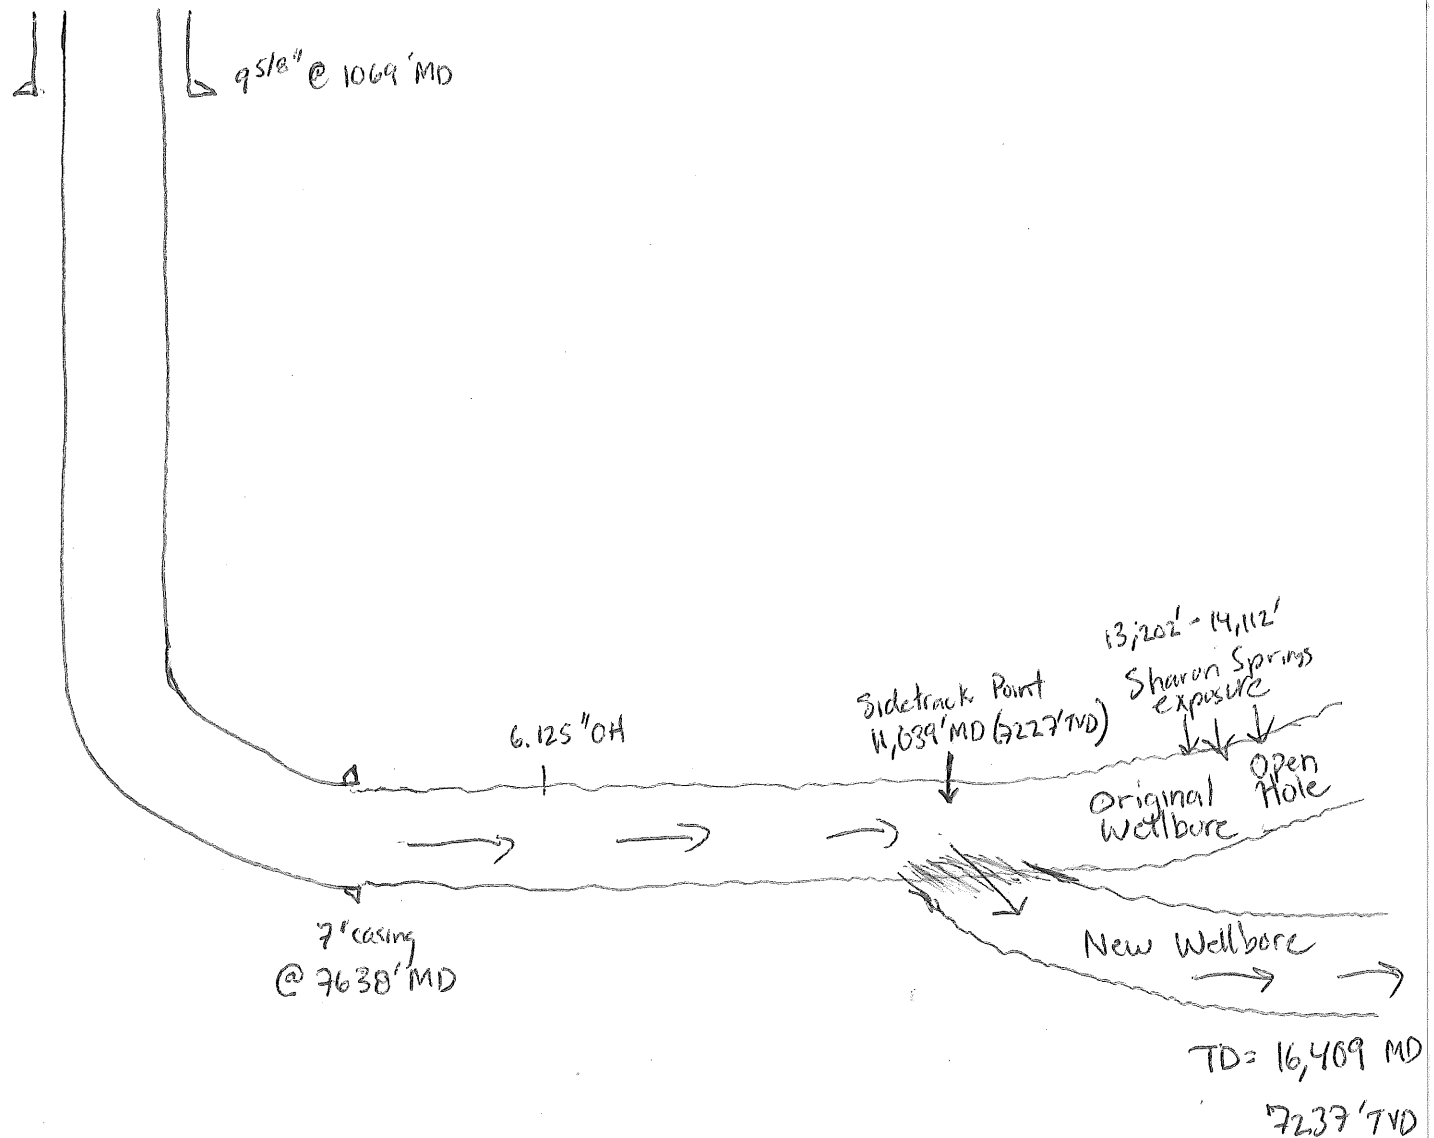

[www.gyrodata.com](http://www.gyrodata.com)

NEW ORLEANS, LA  
504-394-3853

MIDLAND, TX  
432-561-8458

HOUSTON, TX  
281-213-6300

OKLAHOMA CITY, OK  
405-677-0200

LAFAYETTE, LA  
337-981-4436

CORPUS CHRISTI, TX  
361-289-1031

CASPER, WY  
307-234-7241

DALLAS, TX  
214-789-2915

BRIDGEVILLE, PA  
866-599-6445

WILLISTON, ND  
701-572-0670