


WELL LOCATION CERTIFICATE

THIS MAP DOES NOT REPRESENT A BOUNDARY SURVEY

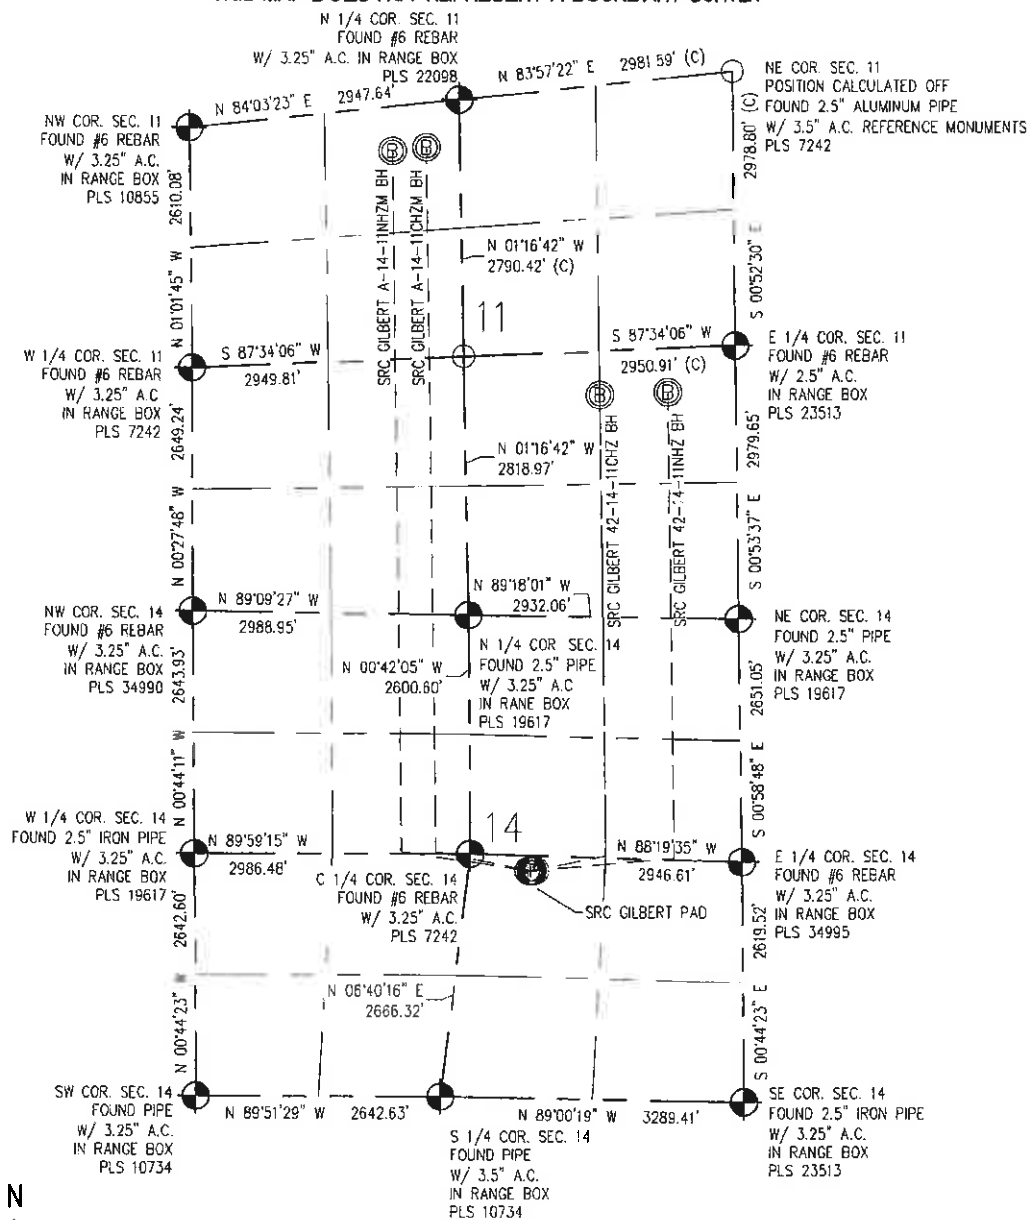

0 2000
Scale 1" = 2000 ft

LEGEND

- - FOUND/SET SURVEY MONUMENT PER MONUMENT RECORD EXCEPTIONS NOTED
- - CALCULATED SURVEY MONUMENT POSITION
- (C) - CALCULATED DIMENSION

NOTICE: According to Colorado law you MUST commence any legal action against Baseline Engineering Corp. within three years after you first discover such defect. In no event may any action based upon any defect in this MLC be commenced more than ten years from this said date of the certification shown hereon.