




Lat40°, Inc. 1635 Foxtrail Drive, Suite 325 Loveland, CO 970-776-3321

# WELL LOCATION CERTIFICATE

C-12

SECTION: 27  
TOWNSHIP: 5N  
RANGE: 63W  
6TH. P.M.  
WELD COUNTY, CO

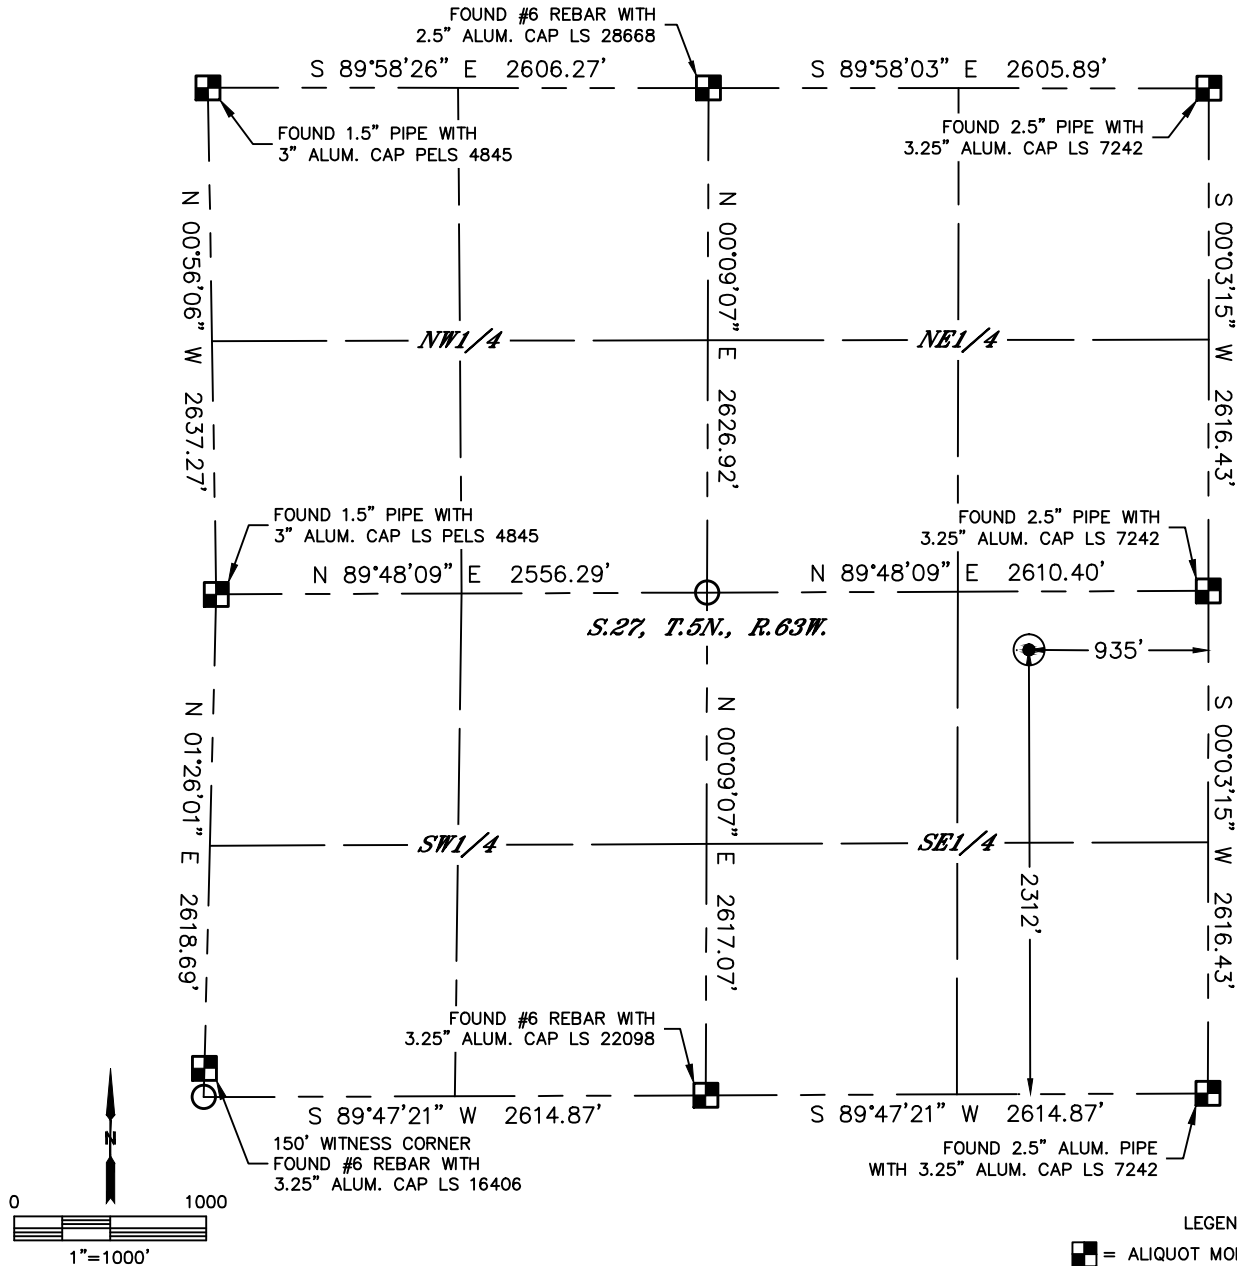


CLIENT: NGL WATER SOLUTIONS DJ, LLC						LANDMAN: DEREK PETRIE			
INSTRUMENT OPERATOR: ADAM KELLY						SURVEY DATE: 11/24/2014		SURFACE USE: RANGELAND	
SHL FOOTAGE			SHL LAT°		SHL LONG°	SHL PDOP	SHL ELEV (FT.)	SHL 1/4/1/4	SHL S-T-R
2312	FSL	935	FEL	40.36952	-104.41591	1.9	4595	NESE	27-5-63

- LEGEND
- = ALIQUOT MONUMENT AS DESCRIBED
  - = CALCULATED POSITION
  - = SURFACE HOLE LOCATION (SHL)
  - ▲ = ENTRY POINT LOCATION (EP)
  - BH = BOTTOM HOLE LOCATION (BHL)
  - ⊕ = EXISTING WELL
  - ⊙ = ABANDONED WELL

## NOTE:

- Bearings shown are Grid Bearings of the Colorado State Plane Coordinate System, North Zone, North American Datum 1983. The lineal dimensions as contained herein are based upon the "U.S. Survey Foot."
- Distances to section lines measured at 90 degrees from said section lines.
- Ground elevations are based on an observed GPS elevation (NAVD 1988 DATUM).
- Latitude and Longitude shown are (NAD 83 DATUM).
- IMPROVEMENTS: See LOCATION DRAWING for all visible improvements within 500' of disturbed area.
- This map does not represent a boundary survey.

NEAREST CULTURAL ITEMS	
BUILDING	±2169' SE
BUILDING UNIT	±3113' SW
HIGH OCCUPANCY BUILDING UNIT	5280'+
DESIGNATED OUTSIDE ACTIVITY AREA	5280'+
PUBLIC ROAD (COUNTY ROAD 69)	±2440' SE
ABOVE GROUND UTILITY	±993' E
RAILROAD	5280'+
PROPERTY LINE	±935' E

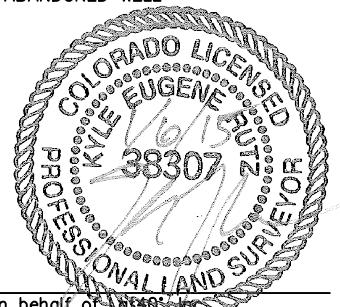

Kyle E. Rutz-On behalf of Lat40°, Inc.  
Colorado Licensed Professional Land Surveyor No. 38307  
DATE: 1/6/2015  
PROJECT#: 2014136