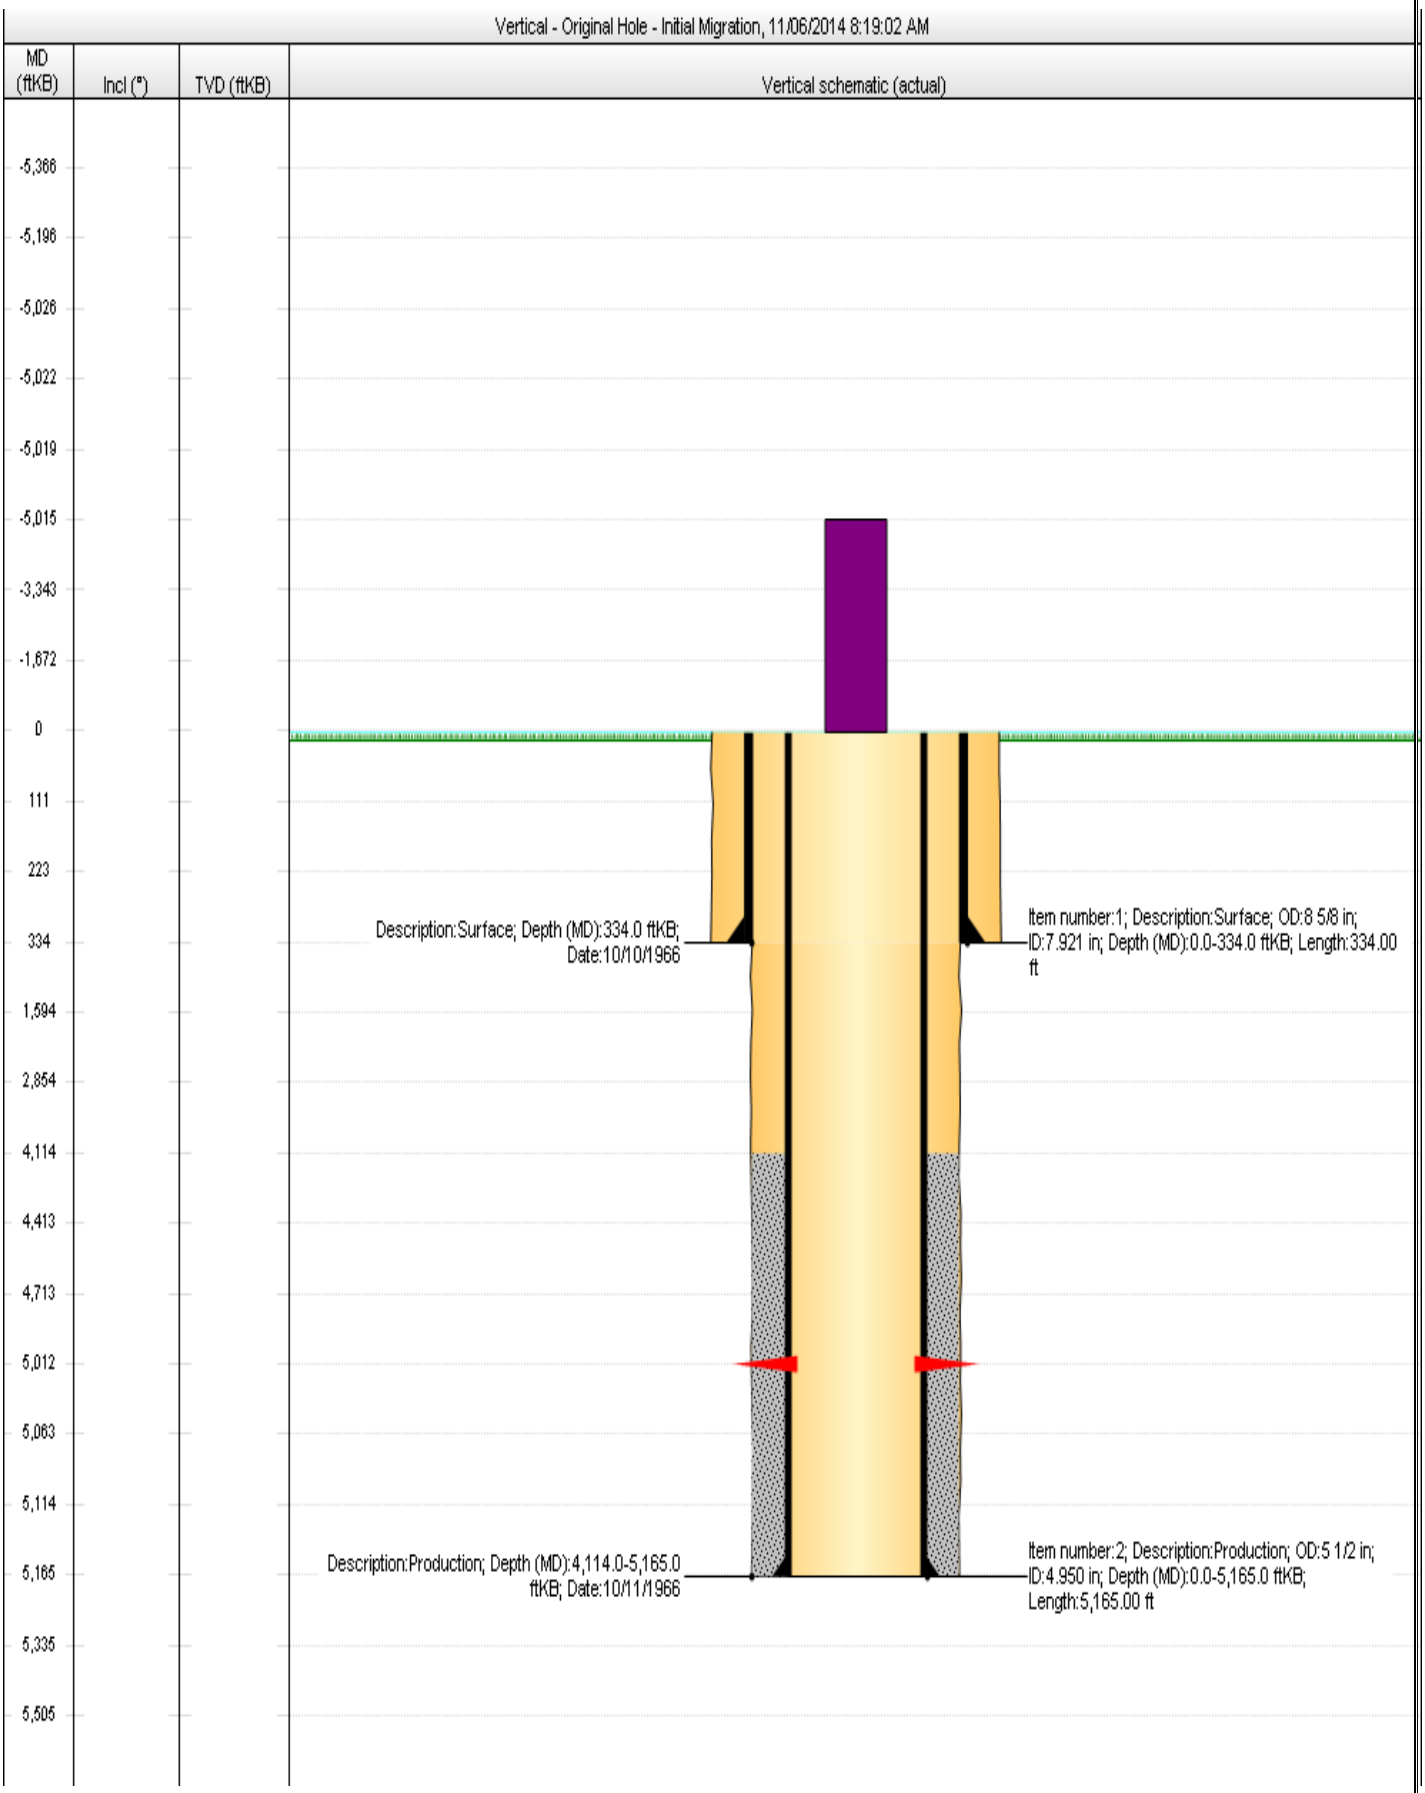
Vertical - Original Hole - Initial Migration, 11/06/2014 8:19:02 AM
MD (ftKB)
Incl (°)
TVD (ftKB)
Vertical schematic (actual)
-5,366
-5,196
-5,026
-5,022
-5,019
-5,015
-3,343
-1,672
0
111
223
334
1,594
2,854
4,114
4,413
4,713
5,012
5,063
5,114
5,165
5,335
5,505
Description:Surface; Depth (MD):334.0 ftKB; Date:10/10/1966
Item number:1; Description:Surface; OD:8 5/8 in; ID:7.921 in; Depth (MD):0.0-334.0 ftKB; Length:334.00 ft
Description:Production; Depth (MD):4,114.0-5,165.0 ftKB; Date:10/11/1966
Item number:2; Description:Production; OD:5 1/2 in; ID:4.950 in; Depth (MD):0.0-5,165.0 ftKB; Length:5,165.00 ft