

**KERR-MCGEE OIL AND GAS ONSHORE LP**  
**RAITH L 15-3**  
**NE NW 15 3N 66W 990' FNL 1,590' FWL**  
**WELD,COLORADO**  
**01/12/2015**

AREA: N1

ROUTE: N14 Spud: 01/08/1980

WINS No.: 02123

AFE/WO#: 2100599

API#: 0512309832

GL: 4862

KB: 4872

MTD: 7981


TVD: 7981

LOG MD:

PBMD: 7931

PBTVD:

Directions: CR 34 & CR 31, E 3/10, S 2.5/10, INTO

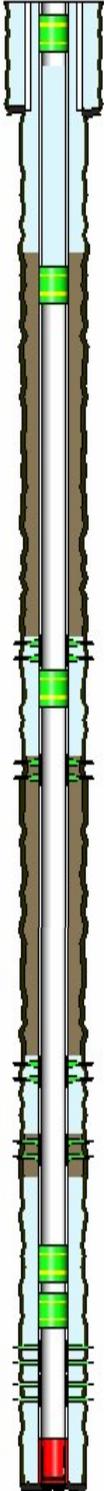

<u>HOLE SECTIONS</u>	<u>Size</u>	<u>Top</u>	<u>Btm</u>	<u>TD Date</u>				
SURFACE	12.25	10	526	01/08/1980				
PRODUCTION	7.88	526	7981	01/17/1980				
<u>TUBULARS</u>	<u>Tool Type</u>	<u>Joints</u>	<u>Size</u>	<u>Weight</u>	<u>Grade</u>	<u>Thread</u>	<u>Top D</u>	<u>Bottom D</u>
SURFACE CASING	Casing	12	8.63	24.00	K-55		10	526
PRODUCTION CASING	Casing	190	4.50	10.50	K-55		10	7980
	Casing Float Shoe	1	4.50				7980	7981
BRIDGE PLUG	CIBP With CMT Cap	1	4.50				7724	7725
BRIDGE PLUG	CIBP With CMT Cap	1	4.50				7640	7641
CAST IRON CEMENT RETAINER	Cast Iron Flow Thru	1	4.50				4249	4250
BRIDGE PLUG	Cast Iron Bridge Plu	1	4.50				1700	1701
BRIDGE PLUG	Cast Iron Bridge Plu	1	4.50				80	81
<u>CEMENT JOBS</u>	<u>Stage</u>	<u>Sacks</u>	<u>Cement Jobs</u>		<u>Top D</u>	<u>Btm D</u>	<u>cbl</u>	
SURFACE CASING	PRIM CMT 1ST STAGE	450	LEAD	FRESH WATER	10	526	No	
PRODUCTION CASING	PRIM CMT 1ST STAGE	200	LEAD	FRESH WATER	7118	7981	No	
PRODUCTION CASING	SQUEEZE JOB	710	LEAD	CEMENT	10	1601	No	
PRODUCTION CASING	ABANDONMENT PLUC	110	LEAD	FRESH WATER	6670	7030	No	
PRODUCTION CASING	ABANDONMENT PLUC	180	LEAD	FRESH WATER	4220	4620	No	
PRODUCTION CASING	ABANDONMENT PLUC	90	LEAD	FRESH WATER	310	1700	No	
<u>PERFORATIONS</u>	<u>Formation</u>	<u>Zone</u>	<u>Top</u>	<u>Btm</u>	<u>Date</u>	<u>Reason</u>	<u>Comments</u>	
			1600	1601	11/08/1994	CEMENT SQUEEZE		
	SUSSEX		4220	4221	12/05/2014	CEMENT SQUEEZE		
	SUSSEX		4620	4621	12/05/2014	CEMENT SQUEEZE		
	NIOBRARA		6670	6671	12/04/2014	CEMENT SQUEEZE		
	NIOBRARA		7030	7031	12/04/2014	CEMENT SQUEEZE		
	NIOBRARA		7040	7041	12/02/2014	CEMENT SQUEEZE		
	J SAND		7784	7790	05/19/1980	PRODUCTION		
	J SAND		7822	7854	05/19/1980	PRODUCTION		

Comments: